


Section 26 Township 27 Range 11-WWell No. #1 SittonCompany Skelly

Cunningham Pool

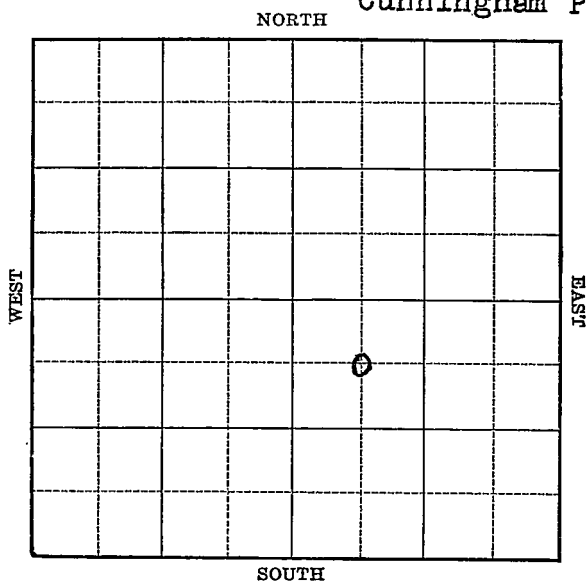

Pratt

KANSAS

Map No. 54 Sec. 26 Twp. 27 R. 11WWell No. 1 SittonSkelly

Company

Contractor

FIRST REPORT
C NW SE660 Ft. from N. Line Ft. from S. Line Ft. from E. Line660 Ft. from W. Line

CUNFINGHAM POOL

SECTION PLAT

		o	

Location Rig up

Drilling and Remarks:

Rotary

RECORD

Cased in., ft.Sand Gas Oil Total Depth

PRODUCTION

1st 24 hrs. Nat. 1st 24 hrs. after shot Gas Cu. Ft.Dry Hole Abandoned

Date

AUG 9 1939₁₉

S. J. LEWIS Scout

Pratt

KANSAS

Map No. _____ Sec. 26 Twp. 27 R. 11WWell No. 1 SittonSkelly

Company

Contractor

~~CUMPLEY~~

SECTION PLAT

		6	

C NW SE

660 Ft. from N. Line

_____ Ft. from S. Line

_____ Ft. from E. Line

660 Ft. from W. Line

CUNNINGHAM POOL

Location _____

Rig up _____

Drilling and Remarks:

Viola 4111 1/2
5" @ 4112 1/2
1000 acid
18,216,000 gal.

RECORD

Cased _____ in., _____ ft.

Sand _____

Gas _____

Oil _____

Total Depth 4129

PRODUCTION

1st 24 hrs. Nat. _____

1st 24 hrs. after shot _____

Gas _____ Cu. Ft.

Dry Hole _____

Abandoned _____

Date

SEP 20 1939

19

S. J. LEWIS

Scout