


Section 27 Township 27 Range 40-W

Well No. #1 Timm

Company United Prod.

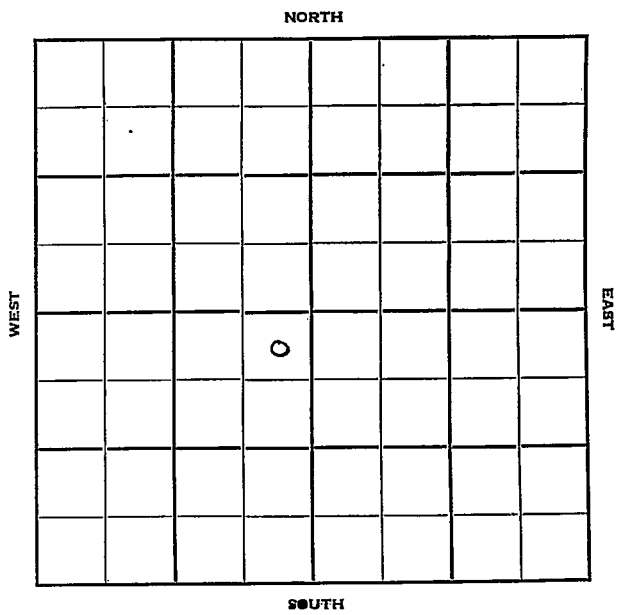

27

27

40-W

Sec. _____ Twp. _____ R. _____

Well No. #1 Timm _____ Farm _____

United Prod. _____ Company _____

Hugoton _____ Contractor _____

_____ Ft. from N. Line

2415


_____ Ft. from S. Line

_____ Ft. from E. Line

2490

_____ Ft. from W. Line

NE SW

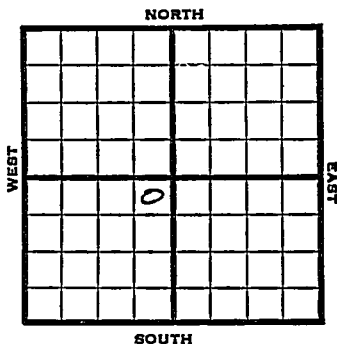

1951

Elev. 3243 REPORT

1/10

Spud 1-8-51
10" @ 463'

2/7

Spud 1/8/51
Gas well TD 2274
10" @463 Hol. 2215 Her. 2241
7" @2237 TD 2274
Krider 2265-79 Win. 2299-2344
Ft. Riley 2374-91
TD 2439 21000 A
Comp. 11,700,000 gas

COMPLETED

