

Section 27 Township 27 Range 6 WWell No. # 1 LampeCompany Cities Service

			0				

NORTH

WEST

EAST

SOUTH

Kingman

KANSAS ✓

Sec. 27 Twp. 27 R. 6WWell No. #1 Lampe Farm _____

Cities Service

Company _____

Contractor _____

330

Ft. from N. Line


Ft. from S. Line

330

Ft. from E. Line

Ft. from W. Line

NE NE NW

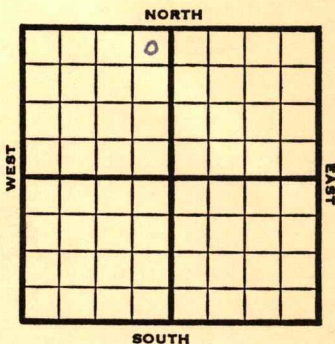

1953

Elev. 1461'

REPORT

8/26

Location

9/2

Drlg 3000'

8" @ 214'

9/9

Howard 2275' Top 2397 Oread 2649

Lans 3004 Miss 3779

DST 3781-3805, 1 hr, 55' M 300#

Drlg. 3970'

9/16

Spud 8-26-53

D & A

TD 4351'

8" @ 214'

Howard 2275, Top 2397, Oread 2649,

Lans 3004, Miss 3779

DST 3781-3805' opn 1 hr, rec 55' mud

300# Kh. 4054, Maq. 4145,

DST 4142-54 opn 1/2 hr, rec 7' mud,

Viola 4181,

DST 4156-88 opn 1 hr, rec 326' sw

Simp. 4194, Arb 4299

TD 4351'

D & A

ABANDONED

County Kingman State KansasSec. 27 (Blk.) 27 (Sur.) 6W Map No.Operator Cities ServiceWell No. 1 Farm LampeElev. _____ Location NE NE NW

			0				

330 Ft. From N Line NW330 Ft. From E Line Quarter1st. Report AUG 26 1953

Completion _____

Remarks _____

Spudding Date _____

Drlg. Data _____

Location _____

County Kingman State KansasSec. 27 (Blk.
Twp.) 27 (Sur.
Rge.) 6W Map No.Operator Cities ServiceWell No. 1 Farm LampeElev. 1461 Location NE NE NW330 Ft. From N Line NW330 Ft. From E Line Quarter1st. ReportCompletion SEP 16 1953RemarksSpudding Date 8-26-53Drlg. Data D & A TD 43518" @ 214 Howard 2275 Top. 2397Oread 2649 Lans. 3004 Miss. 3779DST 3781-3805 open 1 hr. Rec. 55' mud300# Kh. 4054 Maq. 4145 DST 4142-54open $\frac{1}{2}$ hr. Rec. 7' mud Viola 4181DST 4156-88 open 1 hr. Rec. 326' swSimp. 4194 Arb. 4299 TD 4351D & A