

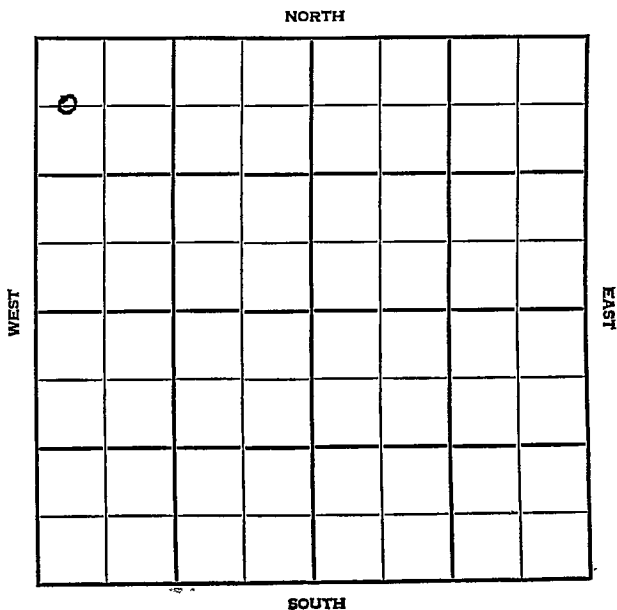
Kingham KANSAS

DX 78-1

Section 27 Township 27 Range 5W

Well No. 1 Henson

Company Bankoff Oil



Kingman KANSAS

SEC.	TWP.	R.
27	27	5W ✓

WELL NO.

1 Henson

FARM

COMPANY

Bankoff Oil

CONTRACTOR

Anschütz

Evan Mound Pool

660

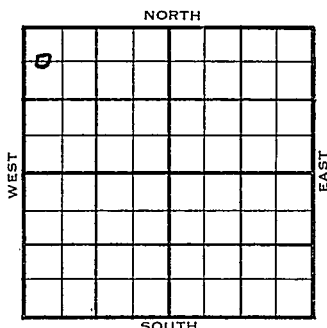
Ft. from N. Line

Ft. from S. Line

Ft. from E. Line

330

Ft. from W. Line

C W $\frac{1}{2}$ NW NW

1954

ELEVATION

1481

REPORT

6/15

8" @ 211

Drlg. 3700

6/23

D&A

TD 3800

8" @ 211 -

Lans. 2966 Miss. 3758

DST 3780-90 open 1 hr. Rec. 90' mud
840#DST 3788-3800 open 1 hr. Rec. 130' gcm
120' socw 240' sw 1160#

TD 3800

D&A

ABANDONED

County Kingman State KansasSec. 27 (Blk. Twp.) 27 (Sur. Rge.) 5W Map No.Operator Bankoff OilWell No. 1 Farm HensonElev. 1481 Location C W $\frac{1}{2}$ NW NW

0					

FIRST REPORT

660 Ft. From N Line NW330 Ft. From W Line Quarter1st. Report JUN 15 1954

Completion

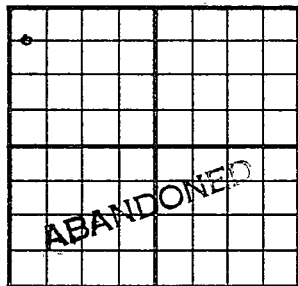
Remarks

Anschutz - Contr.

Spudding Date

Drlg. Data Even Mound Pool8" @ 211 drlg. 3700

J. G. McGEHEE

County Kingman State KansasSec. 27 (Blk. Twp.) 27 (Sur. Rge.) 5W Map No. _____Operator Bankoff OilWell No. 1 Farm HensonElev. 1481 Location C W $\frac{1}{2}$ NW NW660 Ft. From N Line NW330 Ft. From W Line Quarter

1st. Report _____

Completion JUN 23 1954Remarks Evan Mound PoolAnschutz - Contr.

Spudding Date _____

Drilg. Data D & A TD 38008" @ 211 Lans. 2966 Miss. 3758DST 3780-90 open 1 hr. Rec. 90' mud840# DST 3788-3800 open 1 hr. Rec.130' gcm 120' socw 240' sw 1160#TD 3800D & A