

KANSAS

FORM 51 IOM 12-46 PETROL

Section 27 Township 27 Range 1-WWell No. #1 RalstonCompany Alladdin Pet.

WILDEST NORTH

WEST EAST

SOUTH

KANSAS

Sedgwick County

Sec. 27 Twp. 27 R. 1-W

Well No. 1 Ralston Farm
Aladdin Pet. Company

Wildcat


330 Ft. from N. Line

Ft. from S. Line

Ft. from E. Line

330 Ft. from W. Line

N W/C

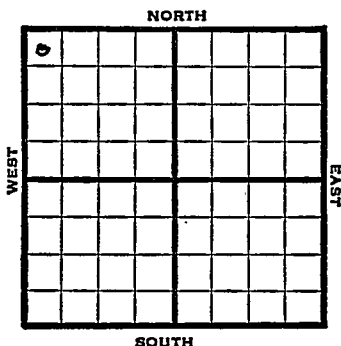

1947

Elev. 1324 REPORT

8/20 8" @ 117'
WOC

8/27 Lansing 2683'
Drlg. 2847'

9/3 Miss. 3240'
Simp. 3625'
TD 3669'

ABANDONED

Map No. _____ Sec. 27 Twp. 27 R. 1W

Well No. 1 Ralston


Aladdin Pet. Company

FIRST REPORT

Contractor

NW/C

SECTION PLAT

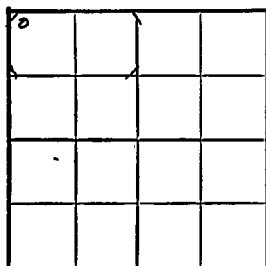

330 Ft. from N. Line

_____ Ft. from S. Line

_____ Ft. from E. Line

330 Ft. from W. Line

Sedgwick County

Location _____

Rig up _____

Drilling and Remarks:

8" @ 117 WOC

RECORD

Cased _____ in., _____ ft.

Sand _____

Gas _____

Oil _____

Total Depth _____

PRODUCTION

1st 24 hrs. Nat. _____

1st 24 hrs. after shot _____

Gas _____ Cu. Ft.

Dry Hole _____

Abandoned _____

Date

AUG 20 1947

19

S. J. LEWIS

Scout

Map No. 38 Sec. 27 Twp. 27 R. 1W

Well No. 1 Ralston

Aladdin Pet.

Company

ABANDONED

Contractor

NW/C


E11824
SECTION PLAT

330 Ft. from N. Line

_____ Ft. from S. Line

_____ Ft. from E. Line

330 Ft. from W. Line

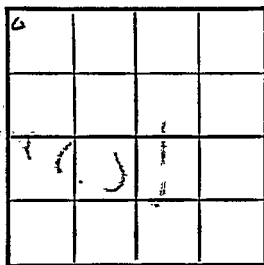

Sedgwick County

Location _____

Rig up _____

Drilling and Remarks:

Miss 3240
Long 3625

RECORD

Cased _____ in., _____ ft.

Sand _____

Gas _____

Oil _____

Total Depth 3662

PRODUCTION

1st 24 hrs. Nat. _____

1st 24 hrs. after shot _____

Gas _____ Cu. Ft.

Dry Hole _____

Abandoned _____

Date

SEP 3 1947 19

S. J. LEWIS

Scout