

State Geological Survey  
WICHITA BRANCH

33-27-27W

TYPE

AFFIDAVIT OF COMPLETION FORM

ACO-1 WELL HISTORY

SIDE ONE

Compt. \_\_\_\_\_

Two (2) copies of this form shall be filed with the Kansas Corporation Commission, 200 Colorado Derby Building, Wichita, Kansas 67202, within thirty (30) days after the completion of a well, regardless of how the well was completed.

Attach separate letter of request if the information is to be held confidential. If confidential, only file one copy. Information on Side One will be of public record and Side Two will then be held confidential.

Applications must be made on dual completion, commingling, salt water disposal, injection and temporarily abandoned wells.

Attach one copy only wireline logs (i.e. electrical log, sonic log, gamma ray neutron log, etc.). (Rules 82-2-105 & 82-2-125) KCC# (316) 263-3238. No Log

LICENSE # 5076 EXPIRATION DATE June 1984

OPERATOR IREX Corp. API NO. 15-069-20,172

ADDRESS 1670 Broadway, Suite 3301 COUNTY Gray

Denver, Colorado 80202 FIELD Unnamed

\*\* CONTACT PERSON Linda Drennen, Production Super. PROD. FORMATION Non-applicable  
PHONE (303) 571-5736 X73

PURCHASER Non-applicable LEASE Bidleman

ADDRESS -- WELL NO. 1

WELL LOCATION SE SE NW 33-27S-27W

DRILLING NRG Drilling, Inc. 330 Ft. from south Line and

CONTRACTOR CONTRACTOR 2310 Ft. from west Line of

ADDRESS P. O. Box 1157 the NW (Qtr.) SEC 33 TWP 27S RGE 27 (W).

Liberal, Kansas 67901

PLUGGING Western Cement

CONTRACTOR CONTRACTOR

ADDRESS Perryton, Texas

TOTAL DEPTH 5400' PBTD --

SPUD DATE 6/28/83 DATE COMPLETED 7/9/83

ELEV: GR 2717' DF 2726' KB 2727'

DRILLED WITH ~~CABLE~~ (ROTARY) ~~TOOLS~~ TOOLS.

DOCKET NO. OF DISPOSAL OR REPRESSURING WELL BEING USED TO DISPOSE OF WATER FROM THIS LEASE N/A

Amount of surface pipe set and cemented 597' DV Tool Used? No

THIS AFFIDAVIT APPLIES TO: (Circle ONE) - Oil, Gas, Shut-in Gas, Dry Disposal, Injection, Temporarily Abandoned, OWWO. Other

ALL REQUIREMENTS OF THE STATUTES, RULES AND REGULATIONS PROMULGATED TO REGULATE THE OIL AND GAS INDUSTRY HAVE BEEN FULLY COMPLIED WITH.


A F F I D A V I T

William H. Bayliff, Operations Mgr., IREX Corp., being of lawful age, hereby certifies that:

I am the Affiant, and I am familiar with the contents of the foregoing Affidavit. The statements and allegations contained therein are true and correct.

W. H. Bayliff

WELL PLAT

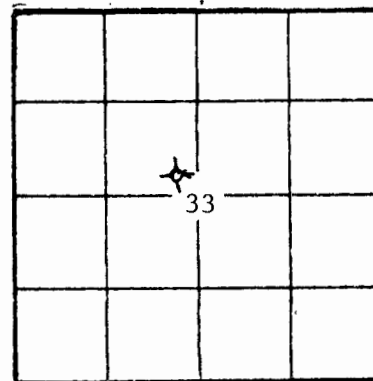

(Office Use Only)

KCC ☒  
KGS ☒

SWD/REP ☐  
PLG. ☐

(W)

SEC. 33 TWP. 27S RGE. 27 (W)

**SHOW GEOLOGICAL MARKERS, LOGS RUN,  
OR OTHER DESCRIPTIVE INFORMATION.**

| FORMATION, DESCRIPTION, CONTENTS, ETC. | TOP   | BOTTOM | NAME | DEPTH |
|----------------------------------------|-------|--------|------|-------|
| Heebner                                | 4262' | 4384'  |      |       |
| Lansing                                | 4384' | 4582'  |      |       |
| Inola                                  | 4582' | 4694'  |      |       |
| Stark                                  | 4698' | 4728'  |      |       |
| Hush                                   | 4728' | 4837'  |      |       |
| Base of K.C.                           | 4837' | 4854'  |      |       |
| Marmaton                               | 4854' | 4938'  |      |       |
| Pawnee                                 | 4938' | 4961'  |      |       |
| Fort Scott,                            | 4961' | 4980'  |      |       |
| Cherokee                               | 4980' | 5148'  |      |       |
| Ste. Genevieve                         | 5148' | 5201'  |      |       |
| St. Louis                              | 5201' | 5400'  |      |       |
| No cores or tests.                     |       |        |      |       |
| TD                                     |       | 5400'  |      |       |