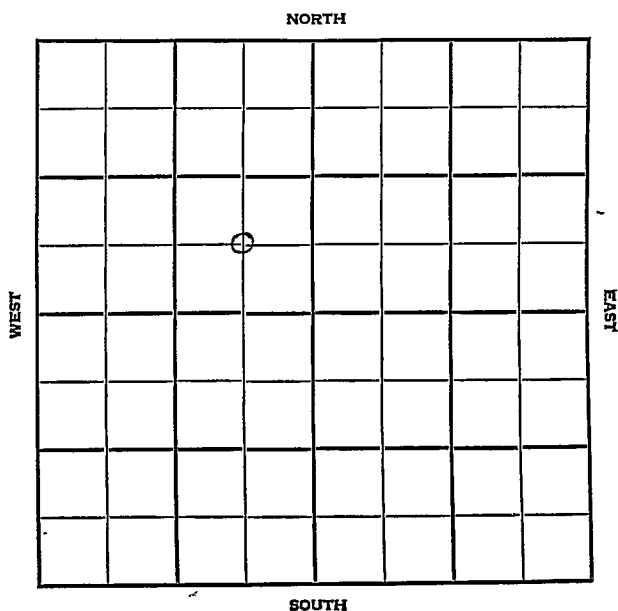


Section 28 Township 27 Range 11WWell No. 1 R. A. GordanCompany Carter Oil

Stanton

Kansas

SEC.	TWP.	R.
28	27	41W
WELL NO.		
#1 R. A. Gordon		FARM
COMPANY		
Carter Oil		
CONTRACTOR		

D: & M


Wildcat

Ft. from N. Line

Ft. from S. Line

Ft. from E. Line

Ft. from W. Line

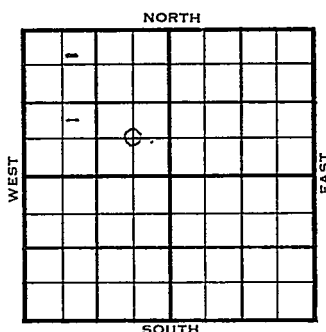

C SE NW

T MI S D-X Lease

	ELEVATION	REPORT
1955	3370'	
7/27	Location	
8/4	Spud: 7/30/55, 13 3/8" @530/600 WEC	
8/21	8 5/8" @1758/200, Drlg 2747	
8/18	Anhy 1785', Ft. Riley 2416, Elmont 3128, Top 3251, Land 3695, Drlg. 4266	
8-25	DST 4766-96, open 2 hr., rec. 30' vsgcm 75/20", drlg. 5047	
9-2	DST 5315-36, failed, DST 5318-36, open 45 min., rec 10' mud 220/3 0", St. Gen. 5380, DST 5327-95, open 2 hr., rec. 30' mud, 250' swcm, 1130/30", drlg. 5560	
9/7	Comm 7-30-55	
	Anh 1785	
	Ft. Riley 2416	
	Elmont 3128	
	Top 3251	
	L 3695	3696
	Morrow sh 5021	5020
	Keyes 5315	5315
	St. Gen 5380	5376
	TD	5599
	OVER	
	OVER	
	OVER	

L(%%


1955

9/7 13 3/8" @ 530
8 5/8" @ 1758 w/200
DST 4766-96 open 2 hr Rec 30' vsgcm
75/20" DST 5315-36 failed
DST 5318-36 open 45 min. Rec 10' mud
220/30"
DST 5327-95 open 2 hr. Rec 30' mud
250' swcm 1130/30"
D & A

ABANDONED

County Stanton Elev. 3370
 Sec. 28 Twp. 27 Rge. 41W
 Company Carter Oil
 Farm Name R. A. Gordon No. 1

TOPS	DEPTH	LOG	DATUM	Loc. in Sec.
Anh.	<u>1785</u>			<u>C SE NW</u>
Tr. <u>7TRiley</u>	<u>2416</u>			
H. <u>Elmint.</u>	<u>3128</u>			
Tr. <u>Top</u>	<u>3251</u>			
Dg.				
Bl.				
L.	<u>3695</u>	<u>21696</u>	<u>325</u>	Geol.
K.C.				Contr.
B.K.C.				
Ce.				
C.				<u>D & M</u>
M. <u>arrow sh</u>	<u>5721</u>	<u>5020</u>	<u>1650</u>	Pool
M. <u>kyas</u>	<u>5315</u>	<u>5315</u>	<u>1945</u>	
K. <u>ST Gen.</u>	<u>5280</u>	<u>5376</u>	<u>2006</u>	
Mz.				<u>Wild cat</u>
Mq.				
V.				
S.				
S.				
A.				
R.				
PE.				
G.				
T.D.		<u>5599</u>		

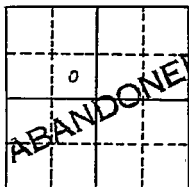

Date Comm. 7-30-55 SEP 7 1955

13 3/8" @ 530 8 5/8" @ 1758/200

DST 4766-96 open 2 hr. Rec. 30' vsgcm

75/20" DST 5315-36 failed DST 5318-36

open 15 min. Rec. 10' mud 220/30"

DST 5327-95 open 2 hr. Rec. 30' mud

250' swcm 1130/30"

D & A.

SEP 15 1955

Scout Cards	<i>M. M. C.</i>
Land Small Map	
Land Wall Map	
Tracings	
France Map	
Pierce Map	
Misc.	

County Stanton Elev. _____
 Sec. 28 Twp. 27 Rge. 41W
 Company Carter Oil
 Farm Name R. A. Gordan No. 1

TOPS

DEPTH

LOG

DATUM

Loc. in Sec. _____

Anh.

C SE NW

Tp.

H.

Tr.

Dg.

Bl.

L.

K.C.

B.K.C.

Ce.

C.

M.

M.

K.

Mz.

Mq.

V.

S.

S.

A.

R.

Pe.

G.

T.D.

Geol. _____

Contr. _____

D & M

Pool

Wildcat

	0	
JUL 27 '35 FIRST REPORT 1 mile		

Date Comm. _____ Miss. test

Location _____

~~34~~
 21

AUG 1 1955

Scout Cards	<i>mmc</i>
Land Small Map	
Land Wall Map	
Tracings	
France Map	
Pierce Map	
Misc.	