


Section 28 Township 27 Range 40W

Well No. #2 C. Winger

Company United Prod.

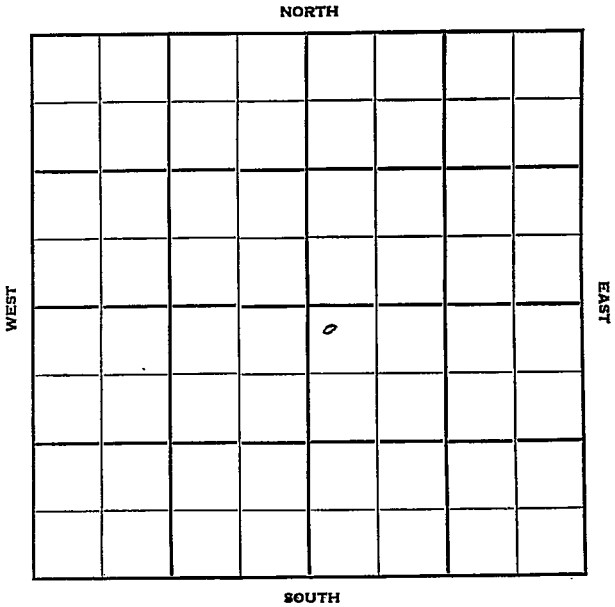

Stanton

Sec. 28 Twp. 27 R. 40W

Well No. #2 C. Winger Farm

United Prod. Company

Contractor

Hugoton Pool


150' Ft. from N. Line

_____ Ft. from S. Line

_____ Ft. from E. Line

150' Ft. from W. Line

NW SE

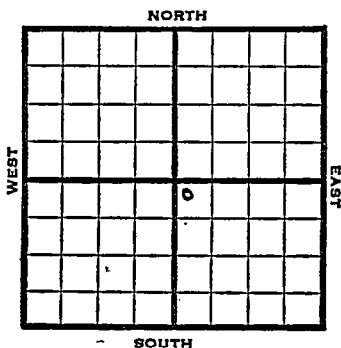

1951,

Elev. 3249' REPORT

2/28

Spud 2-23-51

10" @ 406'

4/4

Spud 2-23-51

Gas Well TD 2440

10" @ 406'

7" @ 2334

TD 2440

Ho. 2207 Her. 2231

Krider 2240 Win. 2290

Ft. Riley 2366

15000 A Comp. 13,200,000 gas

419#

COMPLETED

