

Map No. KANSAS Sec. 29 Twp. 27 R. 10W

Well No. 6-1 Leismann Farm
Shelly Oil Company

NORTH

WEST

EAST

SOUTH

Location _____
Drilling Remarks _____

Rig Up _____
Drilling Remarks _____

RECORD


Cased _____ in. _____ ft.
Sand _____
Gas _____
Oil _____
Total Depth _____

PRODUCTION

1st 24 hrs. Nat. _____
1st 24 hrs. after shot _____
Gas _____ cu. ft. _____
Dry Hole _____
Abandoned _____

Kingman
KANSAS
Map No. 29 Sec. 27 Twp. 10 W
Well No. 6- Leisman Farm
Skelly Oil Company

596 Ft. from N. Line
Ft. from S. Line
Ft. from E. Line
596 Ft. from W. Line

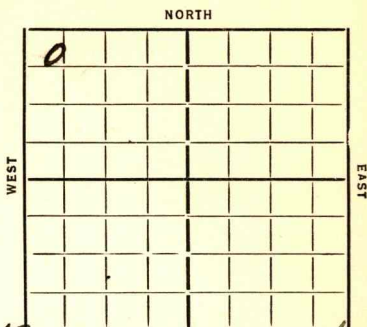

To Be a 2200' test

~~1935~~ **Elev. 1663** REPORT

10/17 Celler
11/1 Sly 600 10" 270
11/7 6" 1993 TD 2150 Rust
11/14
11/20 TD 2150
6 M Gas.

COMPLETED

KANSAS

Map No. 54 Sec. 29 Twp. 27 R. 10WWell No. 6-LeismanSpelly Oil Company

Contractor

SECTION PLAT

0			

596 Ft. from N. Line

Ft. from S. Line

Ft. from E. Line

596 Ft. from W. Line

FIRST REPORT

Location

Rig up

Drilling and Remarks:

cellarTo be 2200'
gas test

RECORD

Cased _____ in., _____ ft.

Sand _____

Gas _____

Oil _____

Total Depth _____

PRODUCTION

1st 24 hrs. Nat. _____

1st 24 hrs. after shot _____

Gas _____ Cu. Ft.

Dry Hole _____

Abandoned _____

Date

ORVAL MANNSCHRECK

10-17-35

192

Scout

KANSAS

Map No. 54 Sec. 29 Twp. 27 R. 10WWell No. 6- LeismanSpelly oil Company

Contractor

COMPLETE

SECTION PLAT

596 Ft. from N. Line

Ft. from S. Line

Ft. from E. Line

596 Ft. from W. Line

0			

Location

Rig up

Drilling and Remarks:

6 m. gas

RECORD

Cased _____ in., _____ ft.

Sand _____

Gas _____

Oil _____

Total Depth 2150

PRODUCTION

1st 24 hrs. Nat. _____

1st 24 hrs. after shot _____

Gas _____ Cu. Ft.

Dry Hole _____

Abandoned _____

Date

ORVAL MANNSCHRECK

11-20-35 192

Scout