


Section 29 Township 27 Range 35 WWell No. # 1 Alexandria "A"Company Columbian Fuel

NORTH

WEST

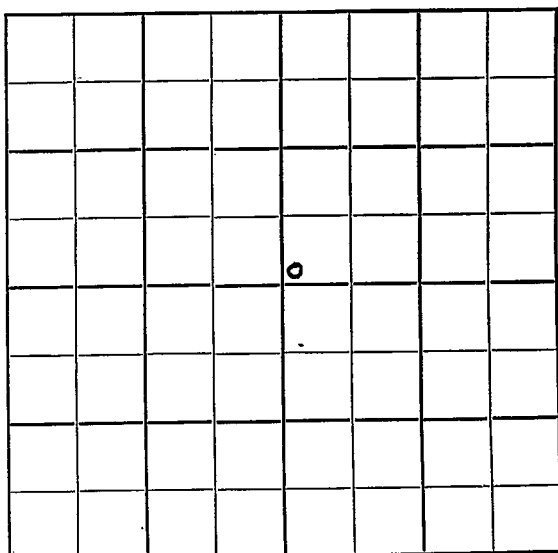

EAST

SOUTH

Grant
27

KANSAS

Sec. 29 Twp. 27 R. 35W

Well No. #1 Alexandria "A" Farm

Columbian Fuel Company


Hugoton Pool Contractor

2540' Ft. from N. Line

Ft. from S. Line

2540' Ft. from E. Line

Ft. from W. Line

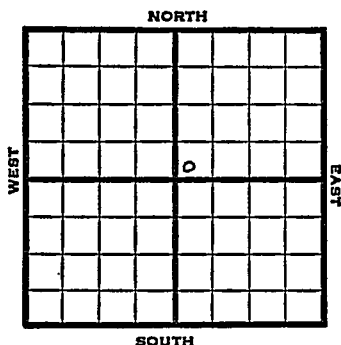

SW NE

1951 Elev. 3088' REPORT

3/21 Spud 3-13-51
10" @ 496'
Drlg. 965'

5/29 Spud 3-13-51
Gas Well TD 2794
10" @ 496 7" @ 2596
TD 2794
Hol. 2525 Her. 2574
Krider 2612 Win. 2636
Ft. Riley 2705 5000 A
Comp. 15,136,000 gas

COMPLETED



Sec. 29 (Bk. Twp.) 27 (Sur. Rge.) 35W Map No.

Well No. 7 Farm Alexandria "A"

Elev.	3088	Location	SW NE
-------	------	----------	-------


2540 Ft. From N Line NE

2540 Ft. From E Line Quarter

1st. Report MAR 21 1951

Completion


Remarks

Spudding Date 5-13-51

Drig. Data	Hugoton Pool
------------	--------------

10" @ 496 drlg. 965

J. E. TYRA

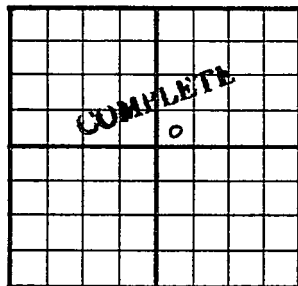County Grant State KansasSec. 29 (Blk.
Twp.) 27 (Sur.
Rge.) 35W Map No.Operator Columbian FuelWell No. 1 Farm Alexandria "A"Elev. 3090 Location SW NE2540Ft. From N Line NE2540Ft. From E Line Quarter1st. ReportCompletion MAY 29 1951Remarks Hugoton PoolSpudding Date 3-13-51Drlg. Data Gas well TD 279410" @ 496 7" @ 2596 TD 2794Hol. 2525 Her. 2574 Krider 2612Win. 2636 Ft. Riley 2705 5000 AComp. 15,136,000 gas

J. E. TYRA