


KANSAS

Sedgwick

Section 29 Township 27 Range 4-W

Well No. #1 De Deirro (DePierre)

Company Cities Service
Bartholomew

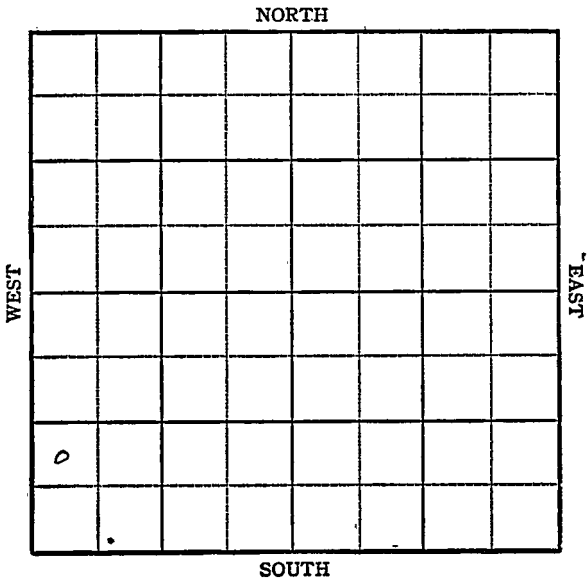

Sedgwick

KANSAS

Sec. 29 Twp. 27 R. 4W ✓

Well No. #1 De Deirro Farm

Cities Service

Bartholomew (Rine.Drlg., Contr.) Company

 Ft. from N. Line

990'


 Ft. from S. Line

 Ft. from E. Line

330'

 Ft. from W. Line

NW SW SW

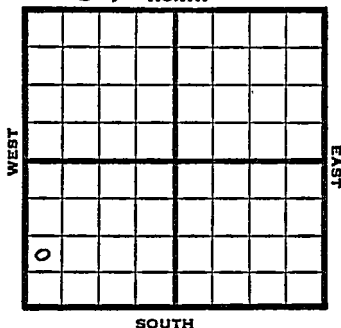

1949

REPORT

11/30

8" @ 189'
Drlg. 1600'

12/7

Drlg 3445'

12/14

Lansing 2863'
Miss 3711'
TD 3745'
5" @ 3723'

1950

1/4

TD 3749'
8"@ 189'
Lans 2863'
Miss 3711'
5"@ 3733'
Flow 160 9 hrs.
Flow 100 5 hrs.
BHB 373 Oil
No wtr.
Comp

COMPLETED

Kansas

Bartholomew

Map No. _____ Sec. 29 Twp. 27 R. 4W

Well No. 1 De Deirro

Cities Service

Company

Rine Drlg.

Contractor

NW SW SW

FIRST REPORT
SECTION PLAT

o	.		

Ft. from N. Line

990

Ft. from S. Line

Ft. from E. Line

330

Ft. from W. Line

Sedgwick County

Location _____

Rig up _____

Drilling and Remarks:

8" @ 189

drlg. 1600

RECORD

Cased _____ in., _____ ft.

Sand _____

Gas _____

Oil _____

Total Depth _____

PRODUCTION

1st 24 hrs. Nat. _____

1st 24 hrs. after shot _____

Gas _____ Cu. Ft.

Dry Hole _____

Abandoned _____

Date

NOV 30 1949

19

S. J. LEWIS

Scout

11-11-23

Map No. _____ Sec. 29 Twp. 27 R. 4WWell No. 1 De Deirco


Cities Service

Company

Contractor

NW SW SW

SECTION PLAT

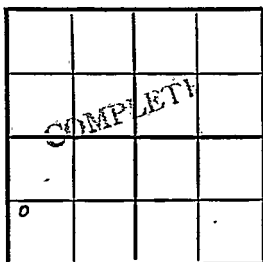

_____ Ft. from N. Line

990 Ft. from S. Line

_____ Ft. from E. Line

330 Ft. from W. Line

Sedgwick County

Location _____

Rig up _____

Drilling and Remarks:

8" @ 189

Lans. 2863

Miss 3711

5" @ 3733

Flow 160 - 7 hrs.

" 100 - 5 hrs.

BHB 373 oil
no water

RECORD

Cased _____ in., _____ ft.

Sand _____

Gas _____

Oil _____

Total Depth 3749

PRODUCTION

1st 24 hrs. Nat. _____

1st 24 hrs. after shot _____

Gas _____ Cu. Ft.

Dry Hole _____

Abandoned _____

Date

JAN 4 1950

19

J. E. Zyma Scout