


Section 29 Township 27 Range 4W
Well No. #2 DePierro
Company Cities Service

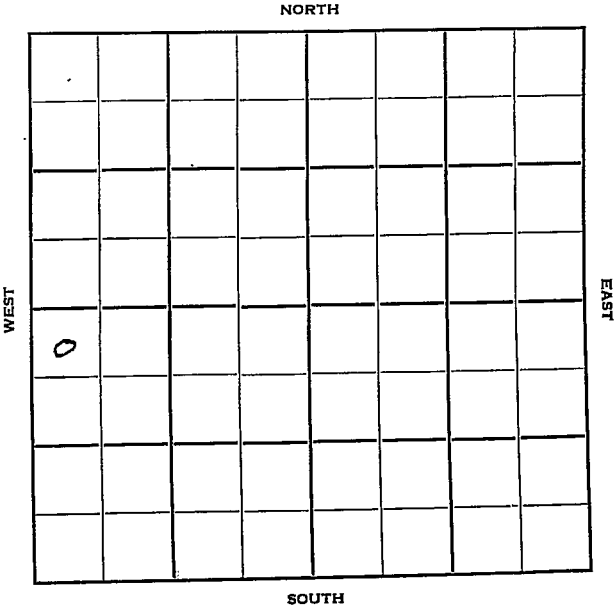

Sedgwick

KANSAS

Sec. 29 Twp. 27 R. 4W

Well No. #2 DePierro Farm

Cities Service

Company

Bartholomew


NORTH

330' Ft. from N. Line

 Ft. from S. Line

 Ft. from E. Line

330' Ft. from W. Line

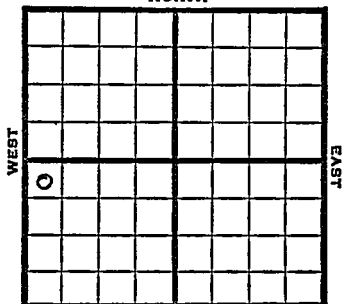

NW NW SW

SOUTH

1950 Elev. 1425' REPORT

1/4 8" @ 240'
Drlg. 1105'
2/8 TD 3759'
8" @ 240'
5" @ 3738'
Miss 3711'
Pay 3750-59'
Flow 116 BO PD
Comp

COMPLETED

Kansas

Bartholomew

Map No. _____ Sec. 29 Twp. 27 R. 4WWell No. 2 DePierro

_____ Cities Service _____ Company

_____ Contractor

NW NW SW


E 1. 1425

SECTION PLAT

330 Ft. from N. Line

_____ Ft. from S. Line

_____ Ft. from E. Line

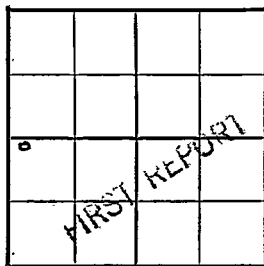330 Ft. from W. Line

Sedgwick County

Location _____

Rig up _____

Drilling and Remarks:

8" @ 240

drlg. 1105

RECORD

Cased _____ in., _____ ft.

Sand _____

Gas _____

Oil _____

Total Depth _____

PRODUCTION

1st 24 hrs. Nat. _____

1st 24 hrs. after shot _____

Gas _____ Cu. Ft.

Dry Hole _____

Abandoned _____

Date

JAN 4 1950

19

J. E. TYRA

Scout

Kansas

Map No. _____ Sec. 29 Twp. 27 R. 4WWell No. 2 De Pierro

Cities Service

Company

Contractor

NW NW SW

E. 1425
SECTION PLAT330 Ft. from N. Line

_____ Ft. from S. Line

_____ Ft. from E. Line

330 Ft. from W. Line

COMPLETE			
o			

Sedgwick County

Location _____

Rig up _____

Drilling and Remarks:

8" @ 240
 5" @ 3738
 Miss 3711
 pay 3750-59
 Flow 116 BOPD

RECORD

Cased _____ in., _____ ft.

Sand _____

Gas _____

Oil _____

Total Depth 3759

PRODUCTION

1st 24 hrs. Nat. _____

1st 24 hrs. after shot _____

Gas _____ Cu. Ft.

Dry Hole _____

Abandoned _____

Date

FEB 8 1950

19

J. E. TYR A Scout