

# KANSAS Grant


Section 3 Township 27 Range 38W

Well No. 1 Schmitz Unit #33

Company Western Natural Gas

Hugoton

NORTH

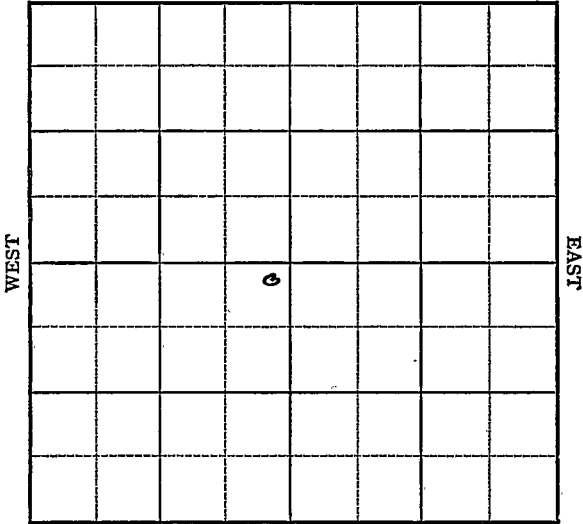

SOUTH

Sec. 3 Twp. 27 R. 38W

Well No. #1 Schmitz Unit #33 Farm

Western Natural Gas Company


Hugoton Pool (Livermore, Cont.) NORTH

150' Ft. from N. Line

\_\_\_\_\_ Ft. from S. Line

150' Ft. from E. Line

\_\_\_\_\_ Ft. from W. Line

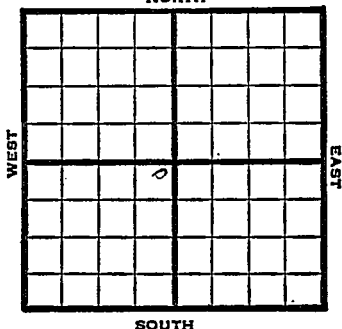

NE SW

1949 Elev 3157' REPORT

6/1 10" @ 592'  
 6/7 D<sub>rlg</sub> 2285'  
 6/15 "  
 6/21 TD 2596'  
 7" @ 2385'  
 5000 acid  
 6/28 "  
 7/6 "  
 7/13 TD 2596'  
 7" @ 2385'  
 228' of 5" Perf Liner  
 @ 2596'  
 22000 acid  
 14,800,000 Gas  
 412# R Pr.  
 Comp  
**COMPLETED**

Map No. \_\_\_\_\_ Sec. 3 Twp. 27 R. 38W

Well No. 1 Schmitz Unit #33

Western Natural Gas Company

Livermore Contractor

NE SW

150 Ft. from N. Line

\_\_\_\_\_ Ft. from S. Line

150 Ft. from E. Line

\_\_\_\_\_ Ft. from W. Line

FIRST REPORT  
SECTION PLAT

	o		

Grant County

Location \_\_\_\_\_

Rig up \_\_\_\_\_

Drilling and Remarks:

10" @ 592

RECORD

Cased \_\_\_\_\_ in., \_\_\_\_\_ ft.

Sand \_\_\_\_\_

Gas \_\_\_\_\_

Oil \_\_\_\_\_

Total Depth \_\_\_\_\_

PRODUCTION

1st 24 hrs. Nat. \_\_\_\_\_

1st 24 hrs. after shot \_\_\_\_\_

Gas \_\_\_\_\_ Cu. Ft.

Dry Hole \_\_\_\_\_

Abandoned \_\_\_\_\_

Date

JUN 1 1949 19

S. J. LEWIS Scout

