


Section 3 Township 27 Range 37-W

Well No. #1 Evans

Company Northern Natural Gas

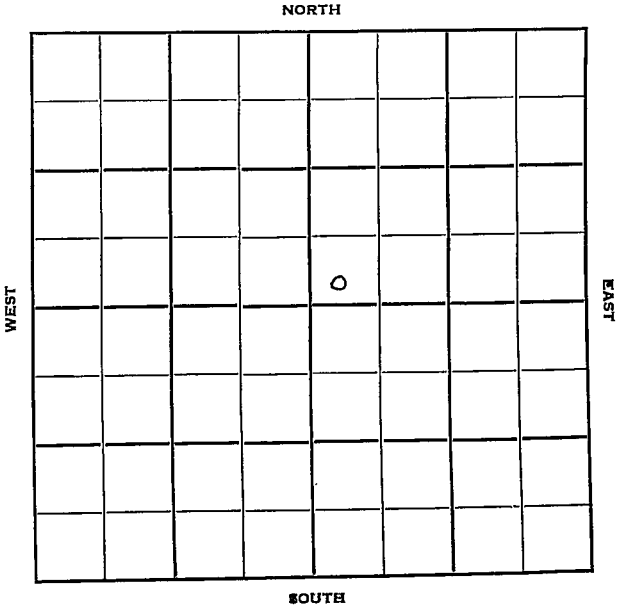

Sec. 3 Twp. 27 R. 37W

Well No. #1 Evans Farm

Northern Natural Gas Company

Contractor

Hugoton Pool


_____ Ft. from N. Line

200' Ft. from S. Line

_____ Ft. from E. Line

200' Ft. from W. Line

SW NE

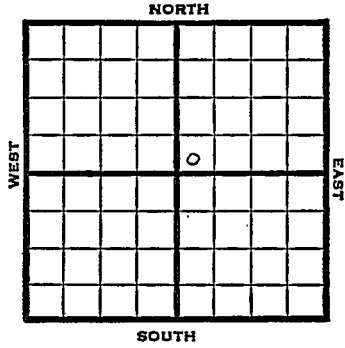

1950	Elev 3081 REPORT
4/5	Spud 4-1-50 10" @ 425' Drlg. 1211'
5/31	10" @ 425 7" @ 2369 TD 2645 282' of 5" liner 12000A Hev 2370 Odell 2436 Ft. Riley 2507 Comp 20,810,000 gas Krider 2420 Win 2462
1	COMPLETED

Kansas

Hugoton Pool

Map No. _____ Sec. 3 Twp. 27 R. 37WWell No. 1 Evans

Northern Natural Gas Company

Contractor _____

SW NE

SECTION PLAT

_____ Ft. from N. Line

200 Ft. from S. Line

_____ Ft. from E. Line

200 Ft. from W. Line

		0	

FIRST REPORT

Grant County

Location _____

Rig up _____

Drilling and Remarks: _____

Spud 4-1-50

10" @ 425

drlg. 1211

RECORD

Cased _____ in., _____ ft.

Sand _____

Gas _____

Oil _____

Total Depth _____

PRODUCTION

1st 24 hrs. Nat. _____

1st 24 hrs. after shot _____

Gas _____ Cu. Ft.

Dry Hole _____

Abandoned _____

Date

APR 5 1950 19

J. E. TYRA

Scout


Scout Cards	APR
Land Small Map	
Land Wall Map	3
Tracings	
France Map	
Pierce Map	
Misc.	

1950

Map No. _____ Sec. 3 Twp. 27 R. 37W

Well No. 1 Evans

Northern Natural Company

SW NE Contractor E1.3081

SECTION PLAT

_____ Ft. from N. Line

200 Ft. from S. Line

_____ Ft. from E. Line

200 Ft. from W. Line

		0	
		COMPLETE	

Grant

Location _____

Rig up _____

Drilling and Remarks:

10" c 425
7" c 2369
T.D. 2645
282' of 5" liner
12000 A

RECORD

Cased _____ in., _____ ft.

Sand _____

Gas _____

Oil _____

Total Depth: 2645

PRODUCTION

1st 24 hrs. Nat. _____

1st 24 hrs. after shot _____

Gas _____ Cu. Ft.

Dry Hole _____

Abandoned _____

Date


MAY 31 1950 19

OVER

J F TYRA Scout



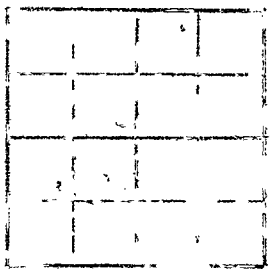





Scout Cards	0561
Land-Small Map	2507
Land-Wall Map	2462
Tracings	2436
France Map	2420
Pierce Map	2370
Misc.	

77. River
 W. W.
 Roll
 (K. K.)
 New.

JUN 20 8 59 AM '41