


Section 3 Township 27 Range 35W

Well No. #1 Dew

Company Columbian Fuel

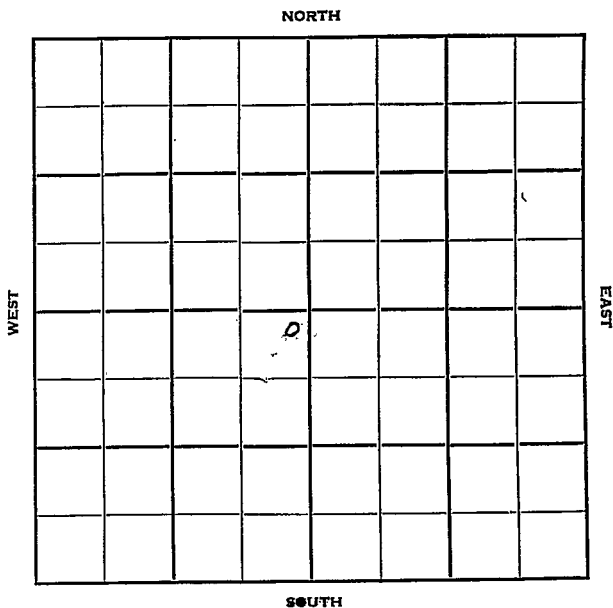

Sec. 3 Twp. 27 R. 35W

Well No. #1 Dew Farm

Columbian Fuel Company

Contractor

Hugoton Pool


100' Ft. from N. Line

Ft. from S. Line

100' Ft. from E. Line

Ft. from W. Line

NE SW

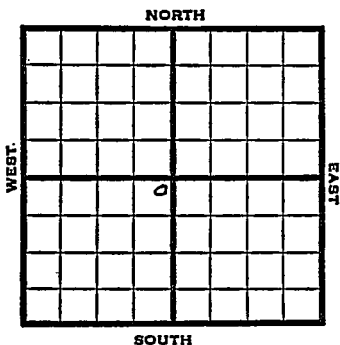

1951 Elev. 3022' REPORT

5/2 10-3/4" @ 548
WOC

7/11 Spud 4-29-51 Gas well TD 2740'
10-3/4" @ 548' Hol 2480'
Her. 2558' TD 2740' 7" @ 2561'
15,000 A
Comp. 17,956,000 gas 385#

COMPLETED

