

Kingman County


FORM 51 5M BRIX

KANSAS

Section 3 Township 27 Range 7W

Well No. 1 Kuhns

Company Phillips

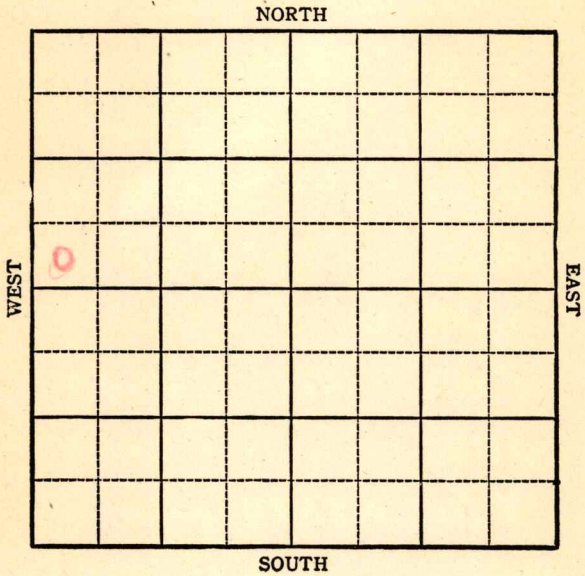

KANSAS

Kingman

Sec. 3 Twp. 27 R. 7W

Well No. #1 Kuhns Farm

Phillips Company

Wildcat

NORTH


 Ft. from N. Line

330' Ft. from S. Line

 Ft. from E. Line

330' Ft. from W. Line

WEST

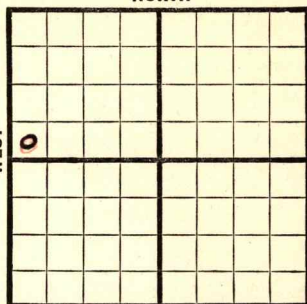

EAST

SOUTH

SW NW Elev. 1571

1944

REPORT

6/28

Location

7/12

8" @ 391

WOC

7/19

Drlg 2588

7/26

Lans 3178

Drlg. 3623

8/9

Arb. 4338

TD 4368

ABANDONED

Pool Name Wildcat

KANSAS
 Map No. 36 Sec. 3 Twp. 27 R. 7W

Well No. 1 KuhnsPhillips

Company

FIRST REPORT

Contractor

SW NW

SECTION PLAT

0			

Ft. from N. Line

330

Ft. from S. Line

Ft. from E. Line

330

Ft. from W. Line

Kingman CountyLocation X

Rig up

Drilling and Remarks:

RECORD

Cased _____ in., _____ ft.

Sand _____

Gas _____

Oil _____

Total Depth _____

PRODUCTION

1st 24 hrs. Nat. _____

1st 24 hrs. after shot _____

Gas _____ Cu. Ft.

Dry Hole _____

Abandoned _____

Date

JUN 28 1944S. J. LEWIS Scout

Pool Name Wild catMap No. 26 Sec. 3 Twp. 27 R. 7WWell No. 1 KuhnsPhillips CompanyABANDONED Contractor

SW NW

SECTION PLAT

6			

Ft. from N. Line330 Ft. from S. LineFt. from E. Line330 Ft. from W. LineKingman County

Location _____

Rig up _____

Drilling and Remarks:

Per 84338

RECORD

Cased _____ in., _____ ft.

Sand _____

Gas _____

Oil _____

Total Depth 4368

PRODUCTION

1st 24 hrs. Nat. _____

1st 24 hrs. after shot _____

Gas _____ Cu. Ft.

Dry Hole _____

Abandoned _____

Date

AUG 9 1944 19 _____S. J. LEWIS Scout