


Section 30 Township 27 Range 10-W

Well No. #4 Interurban Realty

Company Skelly Oil

NORTH Cunningham Pool

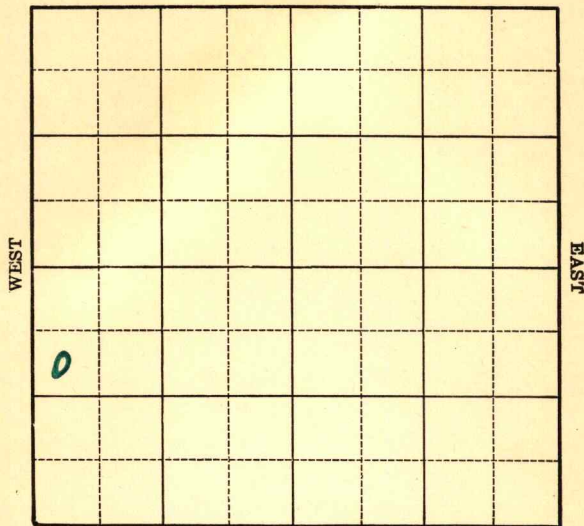

SOUTH

Sec. 30 Twp. 27 R. 10-W

Well No. #4 Interurban Realty Farm

Skelly Oil Company


(Cunningham)

835 Ft. from N. Line

_____ Ft. from S. Line

_____ Ft. from E. Line

335 Ft. from W. Line

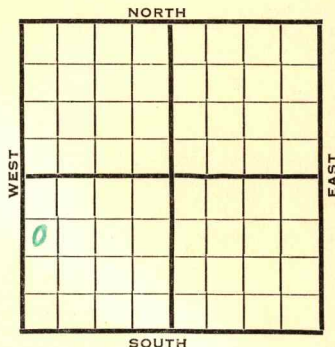

Elev. 1668

| 1940 | REPORT |
|------|------------------------------------|
| 8/14 | Derrick. |
| 8/22 | 8" - 360' Drlg. 1670' |
| 8/29 | Lans. 3404' T.D. 3415' S.O. |
| | 5" - 3407' RUST. |
| | |
| | |
| 9/4 | Lans. 3404' |
| | 5" - 3407' |
| | T.D. 3462' |
| | 7000 acid. |
| | Potential 487 bbls., flow. |
| | |
| | |
| | |
| | COMPLETED |
| | |
| | |
| | |
| | |
| | |
| | |
| | |
| | |
| | |
| | |
| | |
| | |

Map No. _____ Sec. 30 Twp. 27 R. 10W

Well No. 4 Interurban Realty

Skelly Oil Company

Contractor _____

SECTION PLAT

835 SW NW SW
Ft. from N. Line

_____ Ft. from S. Line

_____ Ft. from E. Line

335 Ft. from W. Line

| | | | |
|--|--|--|--|
| | | | |
| | | | |
| | | | |
| | | | |
| | | | |

CUNNINGHAM POOL

Location _____

Rig up _____

Drilling and Remarks:
Derrick

RECORD

Cased _____ in., _____ ft.

Sand _____

Gas _____

Oil _____

Total Depth _____

PRODUCTION

1st 24 hrs. Nat. _____

1st 24 hrs. after shot _____

Gas _____ Cu. Ft.

Dry Hole _____

Abandoned _____

Date

AUG 14 1940

S. J. LEWIS Scout

Map No. 54 Sec. 30 Twp. 27 R. 10W

Well No. 4 Interurban Realty

Skelly Oil Company

Contractor

COMPLETED

SW NW SW

835 Ft. from N. Line

_____ Ft. from S. Line

_____ Ft. from E. Line

335 Ft. from W. Line

CUNNINGHAM POOL

SECTION PLAT

| | | | |
|--|--|--|--|
| | | | |
| | | | |
| | | | |
| | | | |
| | | | |

Location _____

Rig up _____

Drilling and Remarks:

*Lans 3404
5" @ 3407
7000 acid
Flow 487 Pst.*

RECORD

Cased _____ in., _____ ft.

Sand _____

Gas _____

Oil _____

Total Depth 3462

PRODUCTION

1st 24 hrs. Nat. _____

1st 24 hrs. after shot _____

Gas _____ Cu. Ft.

Dry Hole _____

Abandoned _____

Date

SEP 4 1940 19

S. J. LEWIS Scout