

KANSAS

Kingman


Form 51—5M—7-40—Palace

Section 30 Township 27 Range 10-W

Well No. #1 Miles "G"

Company Skelly

NORTH Cunningham Pool

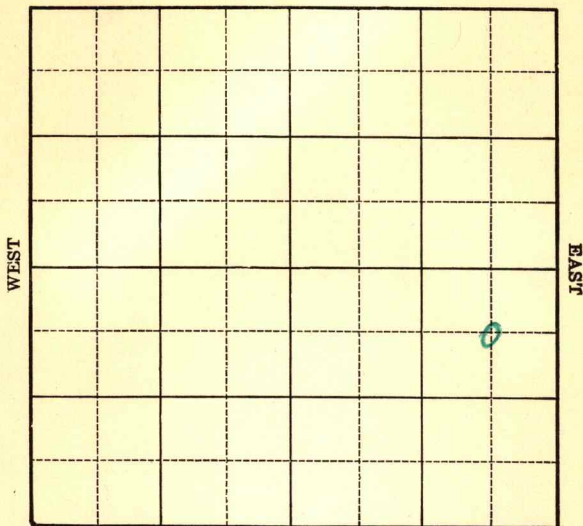

SOUTH

Sec. 30 Twp. 27 R. 10-WWell No. #1 Miles "G" Farm _____Skelly

Company _____

(Cunningham)


660 Ft. from N. Line

_____ Ft. from S. Line

660 Ft. from E. Line

_____ Ft. from W. Line

Elev. 1666

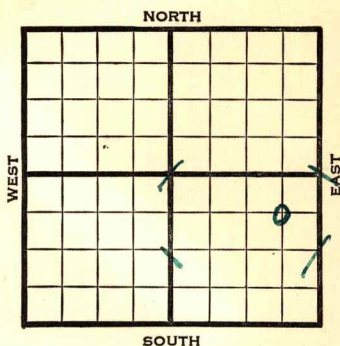

1940	REPORT
10/2	Derrick.
10/10	8" - 361' Drlg. 1440'
10/17	Drlg. 3219'
10/24	Lans. 3405' Kinderhook 3950'
	Viola 4022' 5" - 4024-26' TD.
	RUST.
10/31	T.D. 4040' 24 M gas.
11/7	1000 acid. 68-4/10 M gas.
11/14	" " " "
11/21	" " " "
11/26	Viola 4022'
	5" - 4024'
	T.D. 4040'
	1000 acid.
	53½ M gas.
	COMPLETED

Map No. 54 Sec. 30 Twp. 27 R. 10WWell No. 1 Miles "G"Skelly

Company

Contractor


FIRST REPORT

C NE SE

660 Ft. from N. Line Ft. from S. Line660 Ft. from E. Line Ft. from W. Line

CUNNINGHAM POOL

SECTION PLAT

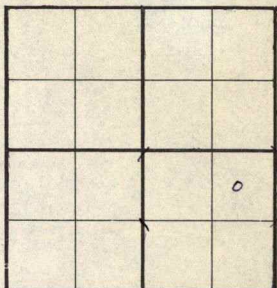Location Rig up

Drilling and Remarks:

Derrick

RECORD

Cased in., ft.Sand Gas Oil Total Depth

PRODUCTION

1st 24 hrs. Nat. 1st 24 hrs. after shot Gas Cu. Ft.Dry Hole Abandoned

Date

OCT 2 1940 19S. J. LEWIS Scout

Map No. 54 Sec. 30 Twp. 27 R. 10WWell No. 1 Miles "G"Skelly Oil

Company

Contractor

COMPLETED

C NE SE

660 Ft. from N. Line Ft. from S. Line660 Ft. from E. Line Ft. from W. Line

CUNNINGHAM POOL

SECTION PLAT

			6

Location Rig up

Drilling and Remarks:

*Viola 4022**5' C 4024.**1000 acid**53 1/2 M Gas*

RECORD

Cased in., ft.Sand Gas Oil Total Depth 4040

PRODUCTION

1st 24 hrs. Nat. 1st 24 hrs. after shot Gas Cu. Ft.Dry Hole Abandoned

Date

NOV 26 1940

19

S. J. LEWIS

Scout