

KANSAS


Form 51—5M—11-31—Palace

Map No. _____ Sec. 30 Twp. 27, R. 10

Well No. *3 - F. C. Miles* Farm

Skelly Oil Company

NORTH

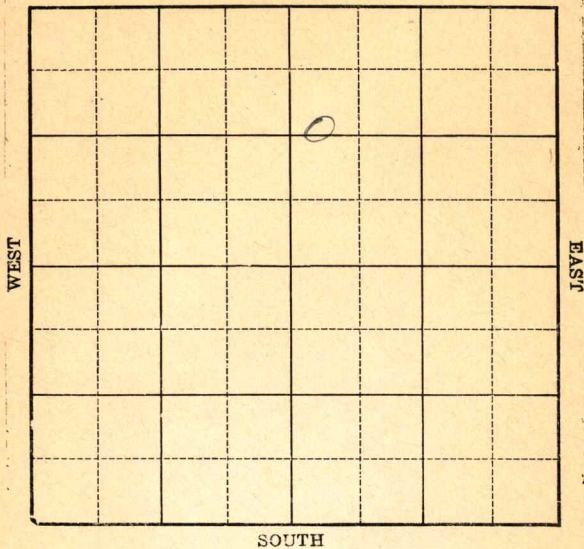

Location

Drilling Remarks

Rig Up

Drilling Remarks

RECORD

Cased _____ in. _____ ft.

Sand

Gas _____

Oil

Total Depth_____

PRODUCTION

1st 24 hrs. Nat.

1st 24 hrs. after shot

Gas _____ cu. ft. _____

Dry Hole

Abandoned

Map No. _____ Sec. 30 Twp. 27 R. 10-W

Well No. 3-F. C. miles Farm _____


Skelly oil Company _____

1320 Ft. from N. Line

_____ Ft. from S. Line

_____ Ft. from E. Line

440 Ft. from W. Line

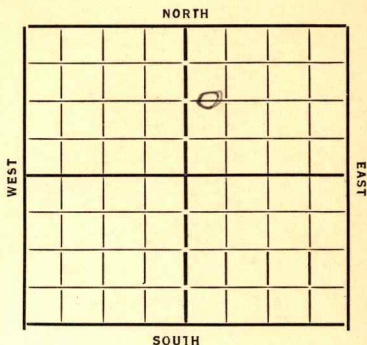

Date

REPORT

1933

8/2 location

8/9 —

8/17 Rgn Rat

8/23 dlg 1375

8/30 " 2630'

9/6 Run 7" at 3394

9/13 RUST

9/20 Pay 3427-35 R.C. 3393 T.D. 3456
slab + flow 427 bbls 24 hr

9/29 —

10/4 K.C. Linn 3393

T.D. 3456

1000 gallon acid

1102 bbls oil

COMPLETED

Map No. 54 Sec. 30 Twp. 27 R. 10W

Well No. 3- F. C. miles

Shelly oil Company

Contractor

SECTION PLAT

1320 Ft. from N. Line

Ft. from S. Line

Ft. from E. Line

440 Ft. from W. Line

COMPLETED

		0	

Location

Rig up

Drilling and Remarks:

1000 gal acid

flow 1102 bbls

RECORD

Cased in., ft.

Sand F.C. Line 3393

Gas

Oil

Total Depth 3456

PRODUCTION

1st 24 hrs. Nat.

1st 24 hrs. after shot

Gas Cu. Ft.

Dry Hole

Abandoned

Date

1007

4 1933

192

O. Mammuch Scout

Map No. 54 Sec. 30 Twp. 27 R. 10W

Well No. 3- F. C. Miles

Skelly Oil Company

Contractor


SECTION PLAT

1320 Ft. from N. Line

..... Ft. from S. Line

..... Ft. from E. Line

440 Ft. from W. Line

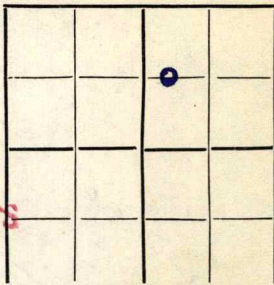

Location ✓

Rig up

Drilling and Remarks:

RECORD

Cased in., ft.

Sand

Gas

Oil

Total Depth

PRODUCTION

1st 24 hrs. Nat.

1st 24 hrs. after shot

Gas Cu. Ft.

Dry Hole

Abandoned

Date

8/7/33 192 O. Manschreck Scout