


Section 30 Township 27 Range 3/W

Well No. 1 Cook

Company Columbian Fuel

Hugoton Pool

NORTH

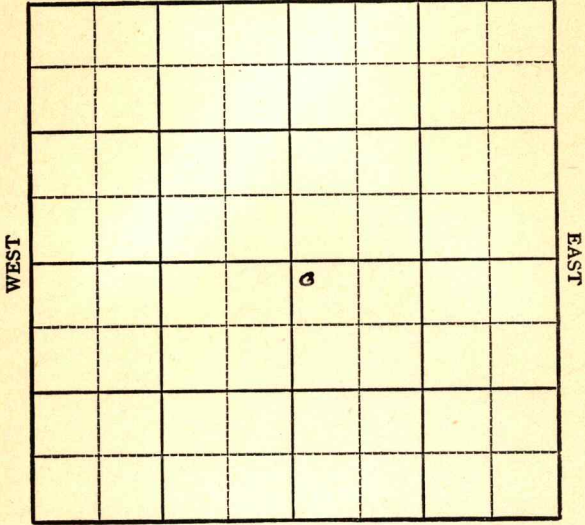

SOUTH



KANSAS

Sec. 30 Twp. 27 R. 34W

Well No. #1 Cook Farm _____

Columbian Fuel Company _____


Hugoton Pool

100' Ft. from N. Line

_____ Ft. from S. Line

_____ Ft. from E. Line

100' Ft. from W. Line

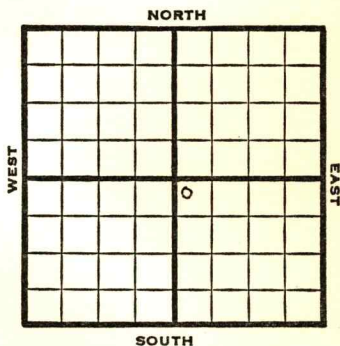

NW SE

1948 **Elev 3031'** REPORT

10/27 Location

11/3 "

11/10 "

11/16 "

11/23 "

11/30 "

12/6 10" @ 600'

12/14 TD 2615'
7" @ 2607'

12/22 "

12/29 TD 2787'
187' of 5" Perf liner @ 2787'

1949
1/12 TD 2787'
7" @ 2607'
187' of 5" Perf Liner @ 2787'
15,000 acid
11,302,000 Gas
420# R Pr.

Comp
COMPLETED

Map No. _____ Sec. 30 Twp. 27 R. 34W

Well No. 1 Cook

Columbian Fuel Company

FIRST REPORT

Contractor

NW SE

SECTION PLAT

100 Ft. from N. Line

_____ Ft. from S. Line

_____ Ft. from E. Line

100 Ft. from W. Line

		0	

Haskell County

Location X

Rig up _____

Drilling and Remarks:

RECORD

Cased _____ in., _____ ft.

Sand _____

Gas _____

Oil _____

Total Depth _____

PRODUCTION

1st 24 hrs. Nat. _____

1st 24 hrs. after shot _____

Gas _____ Cu. Ft.

Dry Hole _____

Abandoned _____

Date

OCT 27 1948

19

S. J. LEWIS Scout

Map No. _____ Sec. 30 Twp. 27 R. 34W

Well No. 1 Cook

Columbian Fuel Company

COMPLETE Contractor

NW SE

E. 13031
SECTION PLAT

100 Ft. from N. Line

_____ Ft. from S. Line

_____ Ft. from E. Line

100 Ft. from W. Line

		0	

Haskell County

RECORD

Location _____

Cased _____ in., _____ ft.

Rig up _____

Sand _____

Drilling and Remarks:

Gas _____

2" @ 2602

Oil _____

Total Depth 2787

187' of 5" Prof. line

@ 2787.

15000 prod

11,302,000 Gas

420 R/A*

PRODUCTION

1st 24 hrs. Nat. _____

1st 24 hrs. after shot _____

Gas _____ Cu. Ft.

Dry Hole _____

Abandoned _____

Date

JAN 12 1949 19

S. J. LEWIS Scout