

Kingman


Form 51—5M—11-31—Palace

Map No. **KANSAS** Sec. 30 Twp. 27 R. 10^W

Well No. 5 F. C. Miles Farm

Skelly Oil Company

NORTH

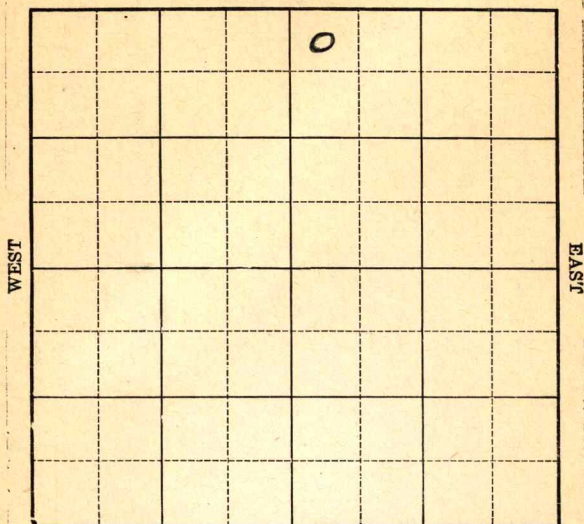

SOUTH

Location

Drilling Remarks

Rig Up

Drilling Remarks

RECORD

Cased in. ft.

Sand

Gas

Oil

Total Depth

PRODUCTION

1st 24 hrs. Nat.

1st 24 hrs. after shot

Gas cu. ft.

Dry Hole

Abandoned

Kingman

Map No. **KANSAS** Sec. 30 Twp. 27 R. 10^W
 Well No. 5 F. C. Miles Farm
 Skelly Oil Company

NORTH

WEST

EAST


SOUTH

440 Ft. from N. Line

Ft. from S. Line

Ft. from E. Line

440 Ft. from W. Line

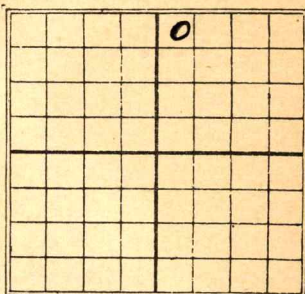Date
1934

REPORT

4/18	Location
4/26	—
5/3	B. R.
5/10	Rur.
5/18	Dlg 1570 12" 317
5/25	" 2870
5/31	" 3100
6/7	PB 2400 Crooked hole
6/14	Dlg 3115
6/21	SD 3115
6/28	Dlg plug TD 3398 7" 3390
7/5	Lansing 3390 TD 3472
	94 Bbls 9 hrs Acidizing
7/12	Reacidizing
7/18	Lansing 3390 TD 3472
	1000 acid 250 Bbls.

COMPLETED

KANSAS

Map No. 54 Sec. 30 Twp. 27 R. 10^W

Well No. 5- F. C. Miles

Shelly Oil Company

Contractor

FIRST REPORT

SECTION PLAT

440 Ft. from N. Line

_____ Ft. from S. Line

_____ Ft. from E. Line

440 Ft. from W. Line

Location 

Rig up _____

Drilling and Remarks:

RECORD

Cased _____ in., _____ ft.

Sand _____

Gas _____

Oil _____

Total Depth _____

PRODUCTION

1st 24 hrs. Nat. _____

1st 24 hrs. after shot _____

Gas _____ Cu. Ft.

Dry Hole _____

Abandoned _____

Date

4-18-34 19

ORVAL MANNSCHRECK

Scout

Kingman **KANSAS**
 Map No. 54 Sec. 30 Twp. 27 R. 10W

Well No. 5-F.C. Miles

Spelly oil Company

Contractor

COMPLETED

SECTION PLAT

		0	

440 Ft. from N. Line

_____ Ft. from S. Line

_____ Ft. from E. Line

440 Ft. from W. Line

Location _____

Rig up _____

Drilling and Remarks:

1000 and

250 bbls

RECORD

Cased _____ in., _____ ft.

Sand Lawrence 3390

Gas _____

Oil _____

Total Depth 3472

PRODUCTION

1st 24 hrs. Nat. _____

1st 24 hrs. after shot _____

Gas _____ Cu. Ft.

Dry Hole _____

Abandoned _____

Date

7-18-34 19

ORVAL MANNSCHRECK

Scout