



Kingman

Form 252-A  
5M 4-32 MPC

Map No. **KANSAS** Sec. 30 Twp. 27 R. 10-W

Well No. 1 So. miles Farm


Skelly Oil Company

330 Ft. from N. Line

\_\_\_\_\_ Ft. from S. Line

1320 Ft. from E. Line

\_\_\_\_\_ Ft. from W. Line

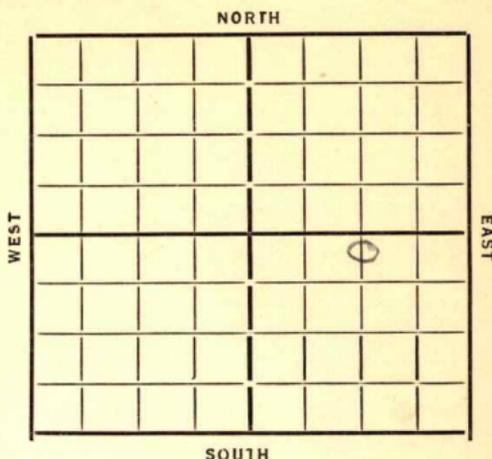

Date	REPORT
1933	
6/14	Rotary Rig
6/21	Surface Pipe 237'
6/28	drlg 2115'
7/5	log pipe 2115'
7/12	
7/19	skidded Rig 15" - 236'
7/26	drlg 2295'
8/2	Cemt 6" 3429
8/9	Rust
8/16	K.C. Lime 3418
	T. D. 3477
	Swab 170 bbls
	<b>COMPLETED</b>

Map No. *54* Sec. *30* Twp. *27* R. *10W*

Well No. *1 - S. Miles*

*Sireely oil* Company

Contractor

**COMPLETED**


**SECTION PLAT**

*330* Ft. from N. Line

Ft. from S. Line

*1320* Ft. from E. Line

Ft. from W. Line

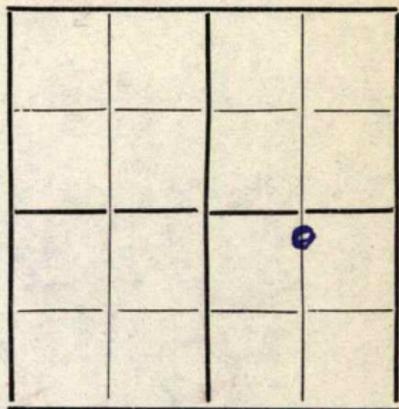

Location

Rig up

Drilling and Remarks:

*1/2 c. Lime  
3418*

*swab 170 lbs*

**RECORD**

Cased in., ft.

Sand

Gas

Oil

Total Depth *3477*

**PRODUCTION**

1st 24 hrs. Nat.

1st 24 hrs. after shot

Gas Cu. Ft.

Dry Hole

Abandoned

Date

*8/16/33* 192 *O. Mannsch* Scout

*Fingman*

Map No. \_\_\_\_\_ Sec. *30* Twp. *27* R. *10W*

*54* Well No. *1 So. miles*

*Spally Oil* Company

Contractor

*© N line SE*


SECTION PLAT

*330* Ft. from N. Line

\_\_\_\_\_ Ft. from S. Line

*1320* Ft. from E. Line

\_\_\_\_\_ Ft. from W. Line

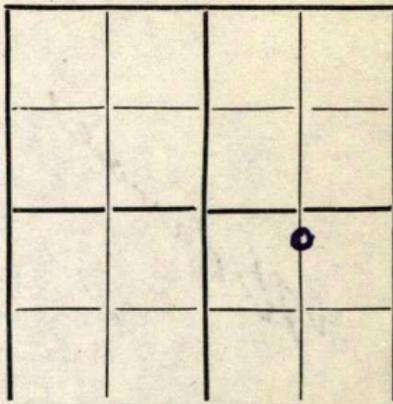

FIRST REPORTS

Location \_\_\_\_\_

Rig up \_\_\_\_\_

Drilling and Remarks:

*Rot. Rig*

RECORD

Cased \_\_\_\_\_ in., \_\_\_\_\_ ft.

Sand \_\_\_\_\_

Gas \_\_\_\_\_

Oil \_\_\_\_\_

Total Depth \_\_\_\_\_

PRODUCTION

1st 24 hrs. Nat. \_\_\_\_\_

1st 24 hrs. after shot \_\_\_\_\_

Gas \_\_\_\_\_ Cu. Ft.

Dry Hole \_\_\_\_\_

Abandoned \_\_\_\_\_

Date

*6/14/33* 192

*Carl M. Amundson* Scout