


Kingman
27 10 W

KANSAS

Map No. _____ Sec. 30 Twp. _____ R. _____

Well No. 2 No. Miles _____ Farm _____
Shelly Oil _____ Company _____

330 Ft. from N. Line
____ Ft. from S. Line
____ Ft. from E. Line
330 Ft. from W. Line

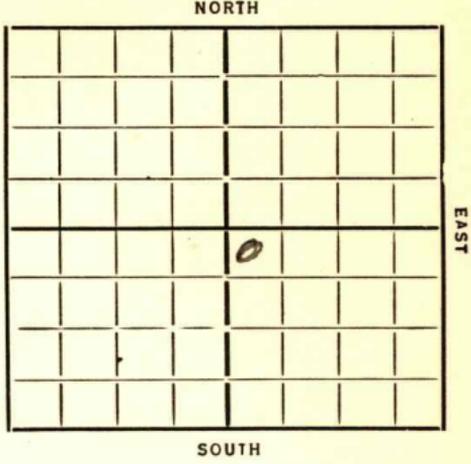

Elev. 1664

Date	REPORT
1935	
11/6	Location
11/14	M.G. Rig
11/21	12 1/2 303 TD 329 WOC
11/29	Alg 2370
12/6	3315
12/13	Trusing 3407 TD 3412
	7" 3410 Alg plugs
12/19	TD 3476 7 1/2 Alg Oil SW to puff hr 2000 acid
12/23	Trusing 3476
	TD 3466
	136 bbls

COMPLETED

Map No. 54 Sec. 30 Twp. 27 R. 10

Well No. 2-So. miles

Shelly oil Compar

Contracto

FIRST REPORTS

SECTION PLAT

330 Ft. from N. Line

..... Ft. from S. Line

..... Ft. from E. Line

330 Ft. from W. Line

		o	

Location

Rig up

Drilling and Remarks:

RECORD

Cased..... in., ft.

Sand

Gas

Oil

Total Depth

PRODUCTION

1st 24 hrs. Nat.

1st 24 hrs. after shot

Gas..... Cu. Ft.

Dry Hole

Abandoned

Date

11-6-35 192

ORVAL MANNSCHRECK

..... Scout

Kingman

KANSAS

Map No. *54* Sec. *30* Twp. *27* R. *10w*

Well No. *2- So. Miles*

Spelly Oil

Company

Contractor

COMPLETE

SECTION PLAT

330 Ft. from N. Line

..... Ft. from S. Line

..... Ft. from E. Line

330 Ft. from W. Line

		0	

Location.....

Rig up.....

Drilling and Remarks:

136 Hls.

RECORD

Cased.....in.,.....ft.

Sand *Lansing 3476*

Gas.....

Oil.....

Total Depth *3466*

PRODUCTION

1st 24 hrs. Nat.....

1st 24 hrs. after shot.....

Gas.....Cu. Ft.

Dry Hole.....

Abandoned.....

Date

ORVAL MANNSCHRECK

12-23-35 192.....

Scout