

KAN 5


Kingman

Form 51-5M-4-36-Palace

Section 30 Township 27 Range 10-W

Well Number #8-Radcliff

Company Skelly Oil

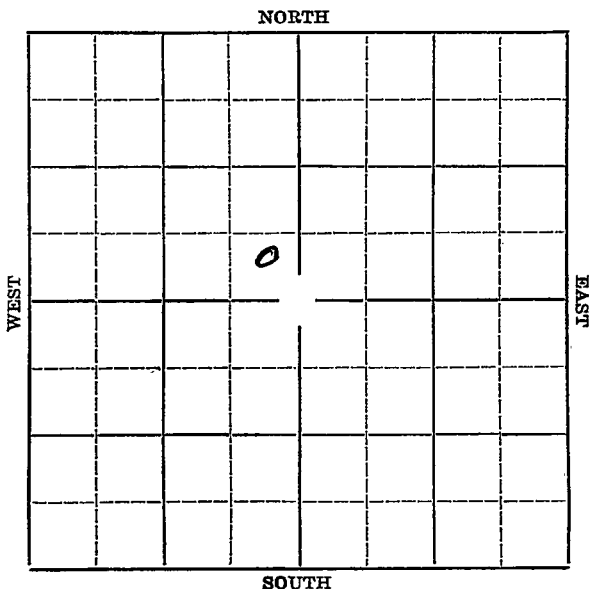

Kingman

Map No. KANSAS Sec. 30 Twp. 27 R. 10W

Well No. #8 Radcliff Farm

Skelly Oil

Company


 Ft. from N. Line

330' Ft. from S. Line

440' Ft. from E. Line

 Ft. from W. Line

Elev. 1669

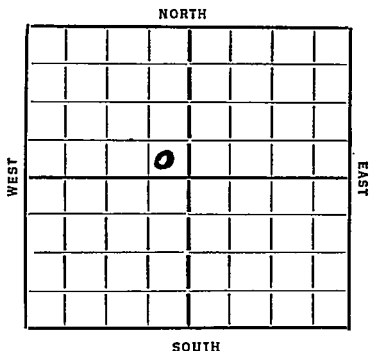

~~1936~~

REPORT

8/5 Location

8/13-- 8/20--8/27-- 9/3--9/10--

9/18 Rig.

9/24 Drlg. 344'.

10/1 Drlg. 1560'.

10/8 Drlg. 2450'.

10/15-Drlg. 2966'.

10/22-Lansing 3395'. Set 8". TD 3408'.

10/29 TD 3410'. 1 bbl per day.

11/6 5M gas 3408 T. D. 3440
acid 2000 No test

11/10 Lansing 3395 T. D. 3440 .
2000 acid. Pot. 192 Oil

COMPLETED

KANSAS

Map No. 54 Sec. 30 Twp. 27 R. 14Well No. 8 RadcliffShelly Oil Company

Contractor

SECTION PLAT

 Ft. from N. Line330 Ft. from S. Line440 Ft. from E. Line Ft. from W. Line

FIRST REPORT

Location ✓Rig up

Drilling and Remarks:

RECORD

Cased in., ft.Sand Gas Oil Total Depth

PRODUCTION

1st 24 hrs. Nat. 1st 24 hrs. after shot Gas Cu. Ft.Dry Hole Abandoned

Date

AUG 5 1936

19

S. J. LEWIS

Scout

KANSAS

Map No. 54 Sec. 20 Twp. 27 R. 10WWell No. 8 RadcliffSteele CompanySteele Contractor

SECTION PLAT

_____ Ft. from N. Line

330 Ft. from S. Line440 Ft. from E. Line

_____ Ft. from W. Line

COMPLETED

Location _____

Rig up _____

Drilling and Remarks:

Leaning 3395-2000 acidP 8 192 oil

RECORD

Cased _____ in., _____ ft.

Sand _____

Gas _____

Oil _____

Total Depth 3440

PRODUCTION

1st 24 hrs. Nat. _____

1st 24 hrs. after shot _____

Gas _____ Cu. Ft.

Dry Hole _____

Abandoned _____

Date

NOV 10 1936 19

S. J. LEWIS

Scout