


Map No. **KANSAS** Sec. **30** Twp. **27** R. **10W**
 Well No. **6-Radcliffe** Farm
Shelly Oil Company
NORTH (Radcliffe)

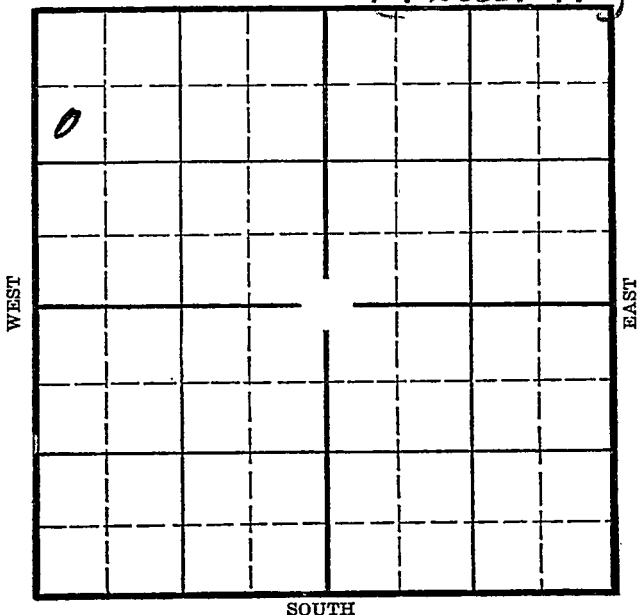

Location _____
 Drilling Remarks _____

RECORD

Cased _____ in. _____ ft.
 Sand _____
 Gas _____
 Oil _____
 Total Depth _____

Rig Up _____
 Drilling Remarks _____

PRODUCTION

1st 24 hrs. Nat. _____
 1st 24 hrs. after shot _____
 Gas _____ cu. ft. _____
 Dry Hole _____
 Abandoned _____

COMPLETED

KANSAS

Map No. 5-4 Sec. 30 Twp. 27 R. 10WWell No. 6-RatcliffeShelly Oil Company

Contractor

FIRST REPORTS

990 Ft. from N. Line

Ft. from S. Line

Ft. from E. Line

440 Ft. from W. Line

SECTION PLAT

0			

Location ✓

Rig up

Drilling and Remarks:

RECORD

Cased in., ft.

Sand

Gas

Oil

Total Depth

PRODUCTION

1st 24 hrs. Nat.

1st 24 hrs. after shot

Gas Cu. Ft.

Dry Hole

Abandoned

Date

ORVAL MANNSCHRECK

9-12-35 192

Scout

KANSAS

Map No. 54 Sec. 30 Twp. 27 R. 10WWell No. 6-RatliffSkelly oil Company

Contractor

COMPLETED

SECTION PLAT

990 Ft. from N. Line

Ft. from S. Line

Ft. from E. Line

440 Ft. from W. Line

<u>10</u>			

Location

Rig up

Drilling and Remarks:

1500 and66 hplb

RECORD

Cased in. ft.Sand KC 3433

Gas

Oil

Total Depth 3473

PRODUCTION

1st 24 hrs. Nat.

1st 24 hrs. after shot

Gas Cu. Ft.

Dry Hole

Abandoned

Date

ORVAL MANNSCHRECK

10-24-35 192

Scout