

Lungman


Form 51-5M-11-31-Palace

Map No. **KANSAS** Sec. 30 Twp. 27 R. 10^W

Well No. 23 J M Radcliff Farm

Shelby Oil Company

NORTH

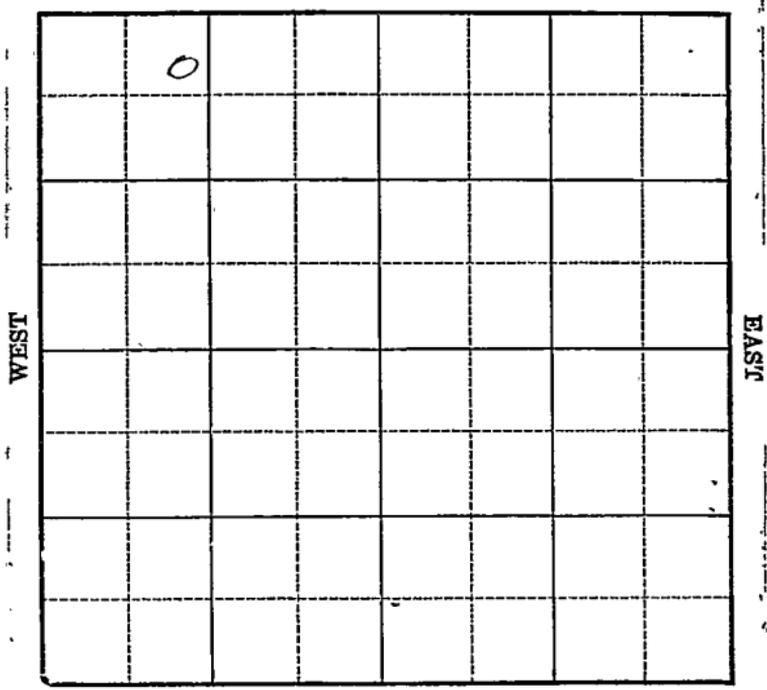

SOUTH

Location _____

Drilling Remarks _____

RECORD

Cased _____ in. _____ ft.

Sand _____

Gas _____

Oil _____

Total Depth _____

Rig Up _____

Drilling Remarks _____

PRODUCTION

1st 24 hrs. Nat. _____

1st 24 hrs. after shot _____

Gas _____ cu. ft.

Dry Hole _____

Abandoned _____

Ligman

Map No. KANSAS Sec. 30 Twp. 27 R. 10^W


Well No. 3 J M Ratchoff Farm
Skelly Oil Company

440 Ft. from N. Line

_____ Ft. from S. Line

_____ Ft. from E. Line

1286 Ft. from W. Line

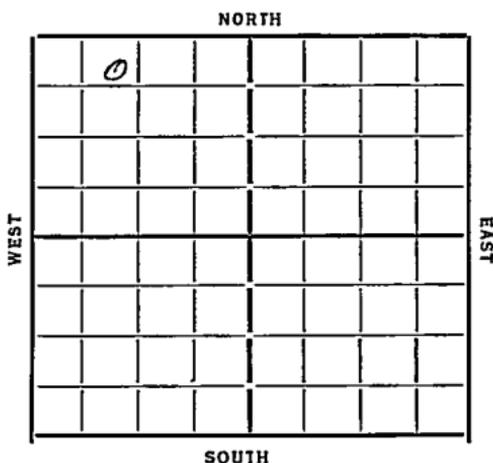

Date 1933

REPORT

<u>12/20</u>	<u>Rig Rot</u>
<u>12/27</u>	<u>Drly 252</u>
<u>1/4</u>	<u>" 2270</u>
<u>1/11</u>	<u>" 3190</u>
<u>1/17</u>	<u>fish 3373</u>
<u>1/24</u>	<u>---</u>
<u>1/31</u>	<u>Skid Rig 40' Truck</u>
<u>2/9</u>	<u>Drly 1665</u>
<u>2/14</u>	<u>" 2690</u>
<u>2/23</u>	<u>Lausing 3405 7" 3405</u> <u>TD 3415</u>
<u>3/1</u>	<u>Rust</u>
<u>3/8</u>	<u>---</u>
<u>3/15</u>	<u>95 3498 1000 Gal acid</u>
<u>3/21</u>	<u>Lausing 3405 95 3498</u> <u>1000 Gal acid 414 Bbls.</u>

COMPLETED

Map No. 54 Sec. 30 Twp. 27 R. 10W

Well No. 3- J. M. Ratliff

Kelly Oil Company

Contractor

FIRST REPORTS

440 Ft. from N. Line

..... Ft. from S. Line

..... Ft. from E. Line

1289 Ft. from W. Line

SECTION PLAT

Location.....

Rig up.....

Drilling and Remarks:

Rig Rot

RECORD

Cased..... in., ft.

Sand.....

Gas.....

Oil.....

Total Depth.....

PRODUCTION

1st 24 hrs. Nat.....

1st 24 hrs. after shot.....

Gas..... Cu. Ft.

Dry Hole.....

Abandoned.....

Date

12-20-33 192 J. Mannscheck Scout

[Handwritten scribbles and lines]

Returned	
25	<i>MAE</i>
1	<i>OK</i>
131	<i>X</i>
111	<i>X</i>
170	<i>X</i>
100	

Map No. 54 Sec. 30 Twp. 27 R. 10W

Well No. 3-J.M. Ratcliff

Spelly oil Company

Contractor

~~COMPLETED~~

SECTION PLAT

0			

440 Ft. from N. Line

_____ Ft. from S. Line

_____ Ft. from E. Line

1289 Ft. from W. Line

Location _____

Rig up _____

Drilling and Remarks:

1000 gal acid

414 bbls

RECORD

Cased _____ in., _____ ft.

Sand casing 3405

Gas _____

Oil _____

Total Depth 3478

PRODUCTION

1st 24 hrs. Nat. _____

1st 24 hrs. after shot _____

Gas _____ Cu. Ft.

Dry Hole _____

Abandoned _____

Date

3/21/34 O. Mammuch Scout



Returned	
Cards	RRS
Tree	OK
Flora	Y
soil Map	X
Map	X
Field Book	
Check	