

Kansas Kingman
 Map No. _____ Sec. 30 Twp. 27 R. 10W
 Well No. #4 J. M. Radcliff Farm
Skelly Oil Company

NORTH

WEST

EAST

SOUTH

Location _____

Drilling Remarks _____

Rig Up _____

Drilling Remarks _____

RECORD

Cased _____ in. _____ ft.

Sand _____

Gas _____

Oil _____

Total Depth _____

PRODUCTION

1st 24 hrs. Nat. _____

1st 24 hrs. after shot _____

Gas _____ cu. ft. _____

Dry Hole _____

Abandoned _____

Kingman

Map No. KANSAS Sec. 30 Twp 27 R. 10 W


Well No. 4 J. M. Ritchiff Farm
S Kelly Oil Company

440 Ft. from N. Line

 Ft. from S. Line

440 Ft. from E. Line

 Ft. from W. Line

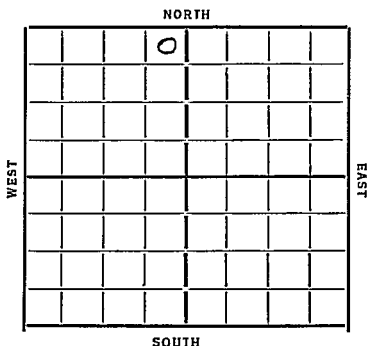

Date 1934

REPORT

3/21 Location
3/28 Moving in
4/5 Dly 200
4/12 " 500
4/19 " 2315
4/26 " 3340
5/3 T Line 3401 6" 3401
5/10 TD 3476 Est 160 oil
acidizing
5/18 K.C.L. 3398 1000 acid
Flow 273 Bbls 24 hrs.
5/23 K.C.L. 3398 TD 3476
Flow 585 Bbls.

COMPLETED

KANSAS

Map No. 54 Sec. 30 Twp. 27 R. 10WWell No. 4-J. M. RatcliffStelly Oil Company

Contractor

FIRST REPORTS**SECTION PLAT**440 Ft. from N. Line

Ft. from S. Line

440 Ft. from E. Line

Ft. from W. Line

Location ✓

Rig up

Drilling and Remarks:

RECORDCased in., ft.Sand Gas Oil Total Depth **PRODUCTION**1st 24 hrs. Nat. 1st 24 hrs. after shot Gas Cu. Ft.Dry Hole Abandoned

Date

3/21/37 192 O. Mainschreck Scout

KANSAS

Map No. 34 Sec. 30 Twp. 27 R. 10WWell No. 4- F. M. RatcliffSpilly oil Company

Contractor

COMPLETED**SECTION PLAT**

	0		

440 Ft. from N. Line

_____ Ft. from S. Line

440 Ft. from E. Line

_____ Ft. from W. Line

Location _____

Rig up _____

Drilling and Remarks:

flow 585
bbls.

RECORD

Cased _____ in. _____ ft.

Sand 15. C. L. 3398

Gas _____

Oil _____

Total Depth 3476**PRODUCTION**

1st 24 hrs. Nat. _____

1st 24 hrs. after shot _____

Gas _____ Cu. Ft.

Dry Hole _____

Abandoned _____

Date

ORVAL MANNSCHRECK5-23-37 19

Scout