


Section 130 Township 27 Range 4W

Well No. 1 Berk

Company Huber et al

Misc.
NORTH

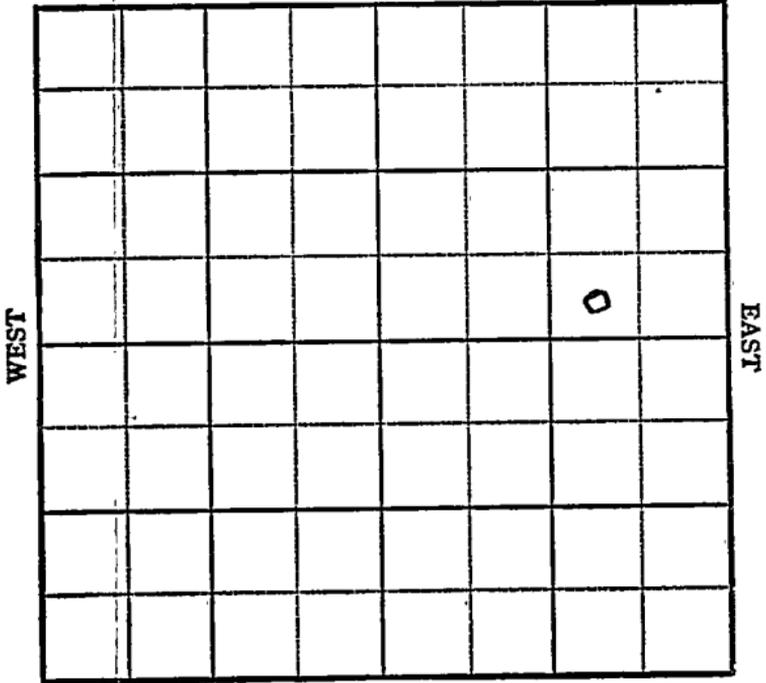

SOUTH

KANSAS

Sedgwick



Sec. 30 Twp. 27 R. 4W

Well No. #1 Berk Farm

Huber et al Company


Miscellaneous

 Ft. from N. Line

330' Ft. from S. Line

990' Ft. from E. Line

 Ft. from W. Line

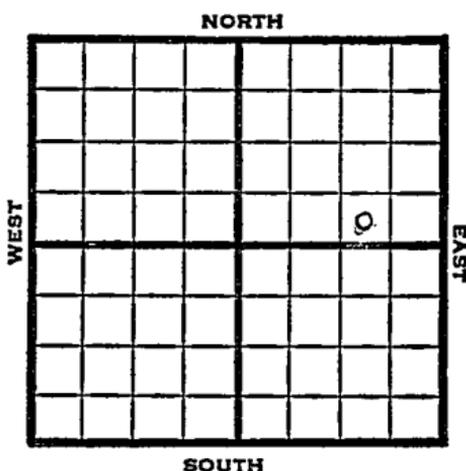

SW SE NE

1949 Elev 1436' REPORT

1/5 Location

1/12 "

1/19 10" @ 195'
Drlg. 2060'

1/26 Lansing 2877'
Drlg 3671'

2/2 Miss 3708'
DST 3714-18 opn 3/4 hrs.
Flowed 40 min

36° Grav
TD 3748

2/9 5" @ 3725'
TD 3750'
Flow in Pits 3 hrs.
no Estimate

2/16 "

2/23 Flow 184 bbls oil in 7 hrs
1" choke

3/2 TD 3750'
Miss 3708'
5" @ 3724'
Bomb Pot 667 Oil
35¹ Gr.

Comp

COMPLETED

Map No. _____ Sec. 30 Twp. 27 R. 4W


Well No. 1 Berk

Huber etal. Company

FIRST REPORT Contractor

SW SE NE

SECTION PLAT

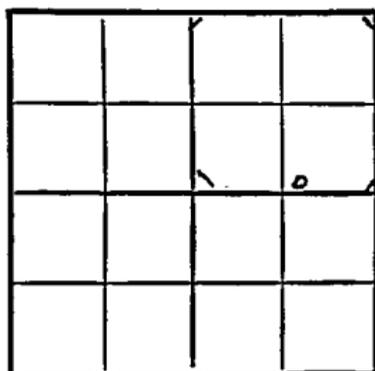

_____ Ft. from N. Line

330 Ft. from S. Line

990 Ft. from E. Line

_____ Ft. from W. Line

Sedgwick County

RECORD

Location X

Cased _____ in., _____ ft.

Rig up _____

Sand _____

Drilling and Remarks;

Gas _____

Oil _____

Total Depth _____

PRODUCTION

1st 24 hrs. Nat. _____

1st 24 hrs. after shot _____

Gas _____ Cu. Ft.

Dry Hole _____

Abandoned _____

Date

JAN 5 1949 19

S. J. LEWIS Scout

Kansas

Map No. K37 Sec. 30 Twp. 27 R. 4W

Well No. 1 Berk

Huber et al. Company

COMPLETE Contractor

SW SE NE

E 11436
SECTION PLAT

			△

_____ Ft. from N. Line

330 Ft. from S. Line

990 Ft. from E. Line

_____ Ft. from W. Line

Sedgwick County

RECORD

Location _____

Cased _____ in., _____ ft.

Rig up _____

Sand _____

Drilling and Remarks:

Gas _____

Misc 3208

Oil _____

5" @ 3724

Total Depth 3750

Bomb P 4667 oil

PRODUCTION

1st 24 hrs. Nat. _____

1st 24 hrs. after shot _____

Gas _____ Cu. Ft.

Dry Hole _____

Abandoned _____

35' - 1/2"

Date

MAR 2 1949 19

S. J. LEWIS Scout