


Section 30 Township KANSAS 27 Range 4-W
Well No. #4 Berk
Company Huber & Prime Drlg.

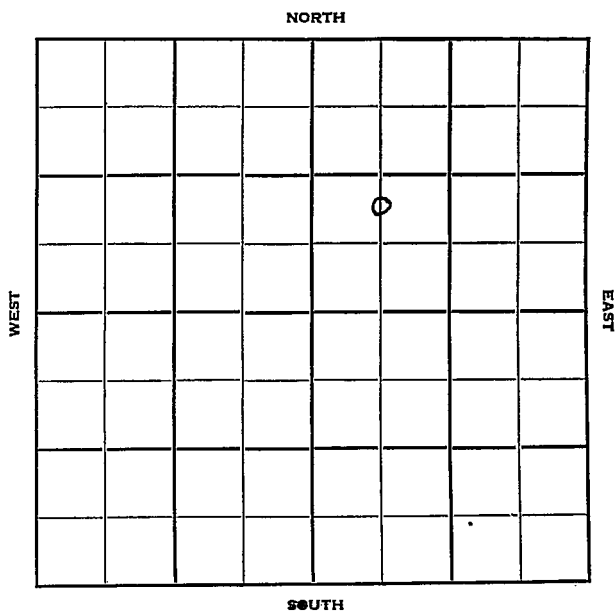

KANSAS
27

Sedgwick

Sec. 30 Twp. 27 R. 4-W ✓

Well No. #4 Berk Farm

Huber & Prime Drlg. Company

Prime Drlg. Contractor

Bartholomew Pool


 Ft. from N. Line

990 Ft. from S. Line

 Ft. from E. Line

660 Ft. from W. Line

C N L SW NE

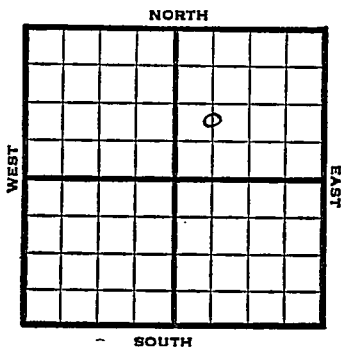

1951

Elev. 1440' REPORT


1/3

S pud 12-27-50
8" @ 202

2/28

Spud 12-27-50
SWD Well TD 4751
8" @ 202'
Miss Chat 3743
Cored 3764-75
Rec. 11' grey green sh
Cored 3775-94
Rec. 19' limestone & sh
Misenor 4090' Viola 4124
Simp. 4142 Arb. 4251
4" @ 4266 TD 4751 Comp. for SWD

ABANDONED

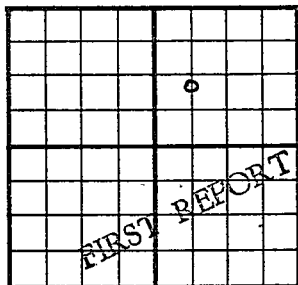County **Sedgwick** State **Kansas**Sec. **30** (Blk. Twp.) **27** (Sur. Rge.) **4W** Map No.Operator **Huber & Prime Drlg.**Well No. **4** Farm **Berk**Elev. Location **C N L SW NE****990** Ft. From **S** Line **NE****660** Ft. From **W** Line Quarter1st. Report **JAN 3 1951**


Completion

Remarks

Prime Drlg. - Contr.Spudding Date **12-27-50**Drlg. Data **Bartholomew Pool****8" @ 202**

J. E. TYRA

County Sedgwick State Kansas
 Sec. 30 (Blk.) 27 (Sur.) 4W Map No.
 Operator Huber & Prime Drlg.
 Well No. 4 Farm Berk
 Elev. 1440 Location C N L SW NE

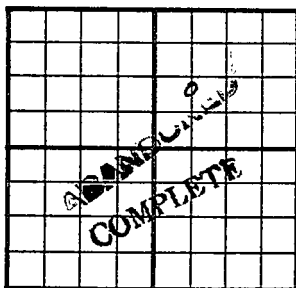

990 Ft. From S Line NE
660 Ft. From W Line Quarter
 1st. Report
 Completion FEB 28 1951
 Remarks Bartholomew Pool
Prime Drlg. - Contr.
 Spudding Date 12-27-50

Drlg. Data SWD well TD 4751

8" @ 202 Miss. chat 3743 Cored 3764-75

Rec. 11' grey green sh. Cored 3775-94

Rec. 19' limestone & shale Misenor 4090

Viola 4124 Simp. 4142 Arb. 4251

4" @ 4266 TD 4751 Comp. for SWD

J. E. TYRA