




*Sedgwick*

Map No. KANSAS Sec. 30 Twp. 29 R. 4W

Well No. 1 Bartholomew Farm  
Magnolia Pet. Company

\_\_\_\_\_ Ft. from N. Line  
330 Ft. from S. Line  
330 Ft. from E. Line  
\_\_\_\_\_ Ft. from W. Line

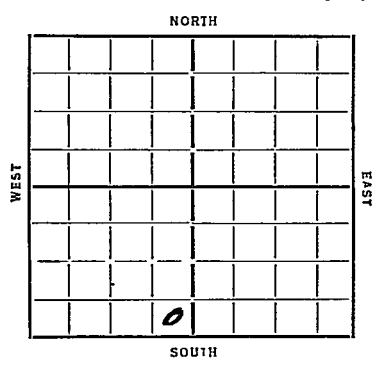

Date	REPORT
<u>11/27</u>	<u>Location</u>
<u>12/6</u>	<u>Bldg. Rot. Rig</u>
<u>12/19</u>	<u>Rgn Rotary</u>
<u>12/21</u>	<u>1 1/2" 211 WOC</u>
<u>12/27</u>	<u>Blg 1460</u>
<u>1/3/35</u>	<u>" 2307</u>
<u>1/10</u>	<u>" 3105 Lansing 2878</u>
<u>1/17</u>	<u>" 3510 2/9/4 S.O. 3376</u>
<u>1/24</u>	<u>Chat <del>3682</del> Rust 3692</u>
<u>1/31</u>	<u>_____</u>
<u>2/7</u>	<u>Chat corrected 3694</u>
	<u>S.G. 3710 3725 29m Gas 3749</u>
	<u>5m Gas</u>
<u>2/14</u>	<u>3790-3800 S.O. W 3823</u>
	<u>5 MW &amp; S.O.</u>
<u>2/21</u>	<u>Blg 3961</u>
<u>2/28</u>	<u>MML 3965 Misener 4060</u>
	<u>7" 4100 Viola 4102 T) 4109</u>
	<u>Rep Boiler</u>
<u>3/6</u>	<u>Wilcox 4129 T) 4148 J &amp; A.</u>

**ABANDONED**

Map No. 37 Sec. 30 Twp. 27 R. 4W

Well No. 1-Bartholomew

Magnolia Pit Company

Contractor

### FIRST REPORTS

.....Ft. from N. Line

330 Ft. from S. Line

330 Ft. from E. Line

.....Ft. from W. Line

### SECTION PLAT


Location

Rig up

Drilling and Remarks:

### RECORD

Cased.....in., .....ft.

Sand.....

Gas.....

Oil.....

Total Depth.....

### PRODUCTION

1st 24 hrs. Nat.....

1st 24 hrs. after shot.....

Gas.....Cu. Ft.

Dry Hole.....

Abandoned.....

Date

**ORVAL MANNSCHRECK**

11-27-34 192

Scout

Map No. 37 Sec. 30 Twp. 27 R. 4W

Well No. 1- Bartholomew

Magnolia pet

Company

Contractor

**ABANDONED**

**SECTION PLAT**

.....Ft. from N. Line

330 Ft. from S. Line

330 Ft. from E. Line

.....Ft. from W. Line


Location.....

Rig up.....

Drilling and Remarks:

**RECORD**

Cased..... in., ..... ft.

Sand Walcof 4129

Gas.....

Oil.....

Total Depth 4148

**PRODUCTION**

1st 24 hrs. Nat.....

1st 24 hrs. after shot.....

Gas.....  Cu. Ft.

Dry Hole.....

Abandoned.....

Date

3-6-35 192

**ORVAL MANNSCHRECK**

Scout