


Section 30 Township 27 Range 4W

Well No. 1 Bartholomew

Company Kingwick

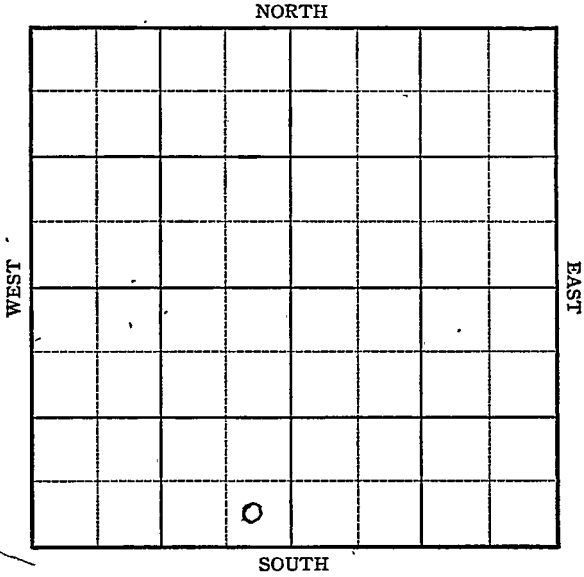

Sec. 30 Twp. 27 R. 4W

Well No. #1 Bartholomew Farm
Kingwick Company


Wildcat

 Ft. from N. Line

400 Ft. from S. Line

330 Ft. from E. Line

 Ft. from W. Line

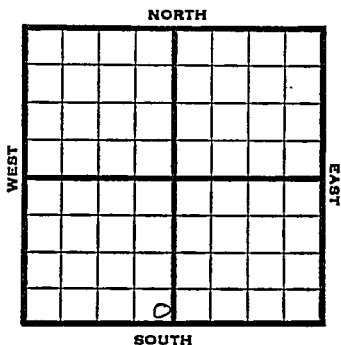

SE SW

1946 Elev. 1418 REPORT

5/22 Twin Well
Location

5/29 8" @ 183
Drlg. 1438'

6/5 Drlg. 3213'

6/12 Lans 2875
Miss 3692
3695 TD
5" @ 3694 RUST

6/18 " " "

6/26 TD 3732-
450,000 Gas

7/3 " "

7/9 " "

7/16 " "

7/23 TD 3737
Est 5 M Gas

7/31 Miss. 3692
5" @ 3694
TD 3737
500 acid.
5 M. Gas

COMPLETED

KANSAS

Kansas Pool Name Wildcat

Map No. 37 Sec. 30 Twp. 27 R. 4W

Well No. II Bartholomew

Kingwick Company

FIRST REPORT

Contractor

SE SW

SECTION PLAT

_____ Ft. from N. Line

400 Ft. from S. Line

330 Ft. from E. Line

_____ Ft. from W. Line

Sedgwick County

Location _____

Rig up _____

Drilling and Remarks:

Twin well

RECORD

Cased _____ in., _____ ft.

Sand _____

Gas _____

Oil _____

Total Depth _____

PRODUCTION

1st 24 hrs. Nat. _____

1st 24 hrs. after shot _____

Gas _____ Cu. Ft.

Dry Hole _____

Abandoned _____

Date

MAY 22 1946 19

S. J. LEWIS Scout

KANSAS Kansas Pool Name Wildcat

Map No. 37 Sec. 30 Twp. 27 R. 4W

Well No. 1 Bartholomew

Kingwick Company

COMPLETED

Contractor

SE SW

E. 1/4 1/4
SECTION PLAT

_____ Ft. from N. Line

400 Ft. from S. Line

330 Ft. from E. Line

_____ Ft. from W. Line

Sedgwick County

Location _____

Rig up _____

Drilling and Remarks:

Miss 3682
5" @ 3694
500 acid
501 Gas

RECORD

Cased _____ in., _____ ft.

Sand _____

Gas _____

Oil _____

Total Depth 8287

PRODUCTION

1st 24 hrs. Nat. _____

1st 24 hrs. after shot _____

Gas _____ Cu. Ft.

Dry Hole _____

Abandoned _____

Date

JUL 3 1 1946 19

S. J. LEWIS Scout