


Section 30 Township 27 Range 1W

Well No. #3 Bartholomew

Company Kingwick Oil & Gas

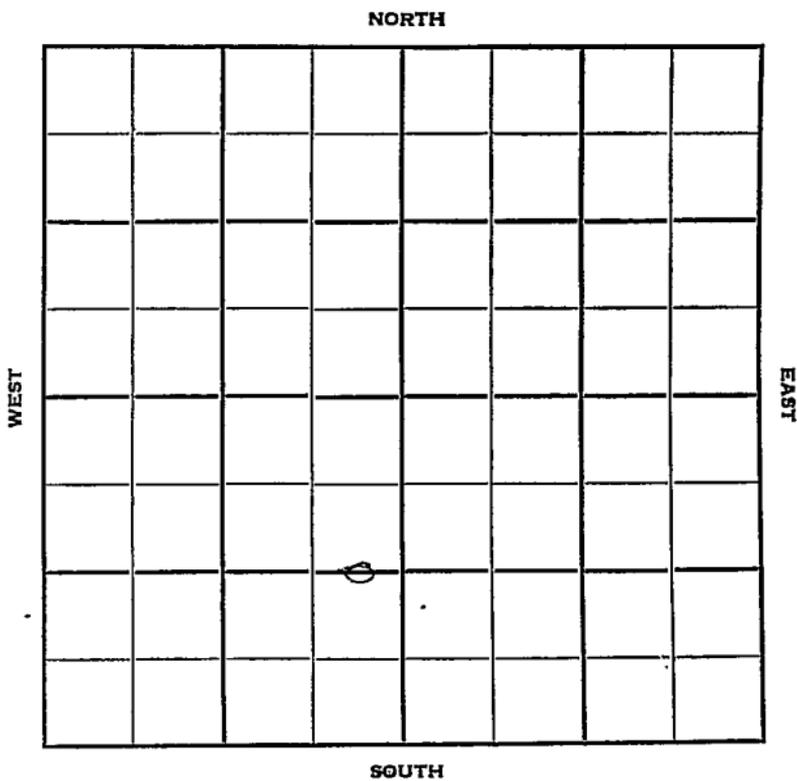

Sec. 30 Twp. 27 R. 4 W

Well No. # 3 Bartholomew Farm

Kingwick Oil & Gas Company

Sterling Contractor  
Bartholomew


Ft. from N. Line

1320 Ft. from S. Line

320 Ft. from E. Line

Ft. from W. Line

C E/2 E/2 SW

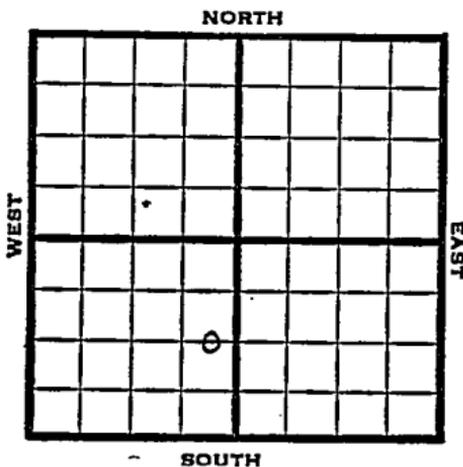

1951 Elev. 1425' REPORT

9/19 Spud 9-15-51  
10" @ 160'  
Drilling 918'

1952

2/6 TD 3742 5" @ 3737

2/13 NR

2/20 "

3/5 NR

3/12 "

3/19 "

3/24 "

4/1 "

4/9 "

4/23 "

4/30 "

5/7 "

5/14 "

5/21 "

5/28 "

6/11 "

6/18 "

6/25 "

7/2 "

7/9 "

7/17 "

1952 -

7/23 10 Bopd

7/30 NR

8/6 "

8/13 "

8/20 "

8/27 Spud 9-15-51

Oil Well TD 3751' 10" @ 160'

Lans. 2884

DST 3296-3305 open 1 hr. rec. 20'  
mud & wtr. & SSO & gas

Miss dol. 3737 5" @ 3737'

TD 3751' F/ 35 bopd Comp. 10 bopd

**COMPLETED**

County Sedgwick State Kansas

Sec. 30 (Blk. 27) (Sur. 4W) Map No.

Operator Kingwick Oil & Gas

Well No. 3 Farm Bartholomew

Elev. Location CE/2 E/2 SW


FIRST REPORT

1320 Ft. From S Line SW

320 Ft. From E Line Quarter

Ist. Report SEP 19 1951

Completion \_\_\_\_\_

Remarks \_\_\_\_\_

Sterling - Contr.

Spudding Date 9-15-51

Drlg. Data Bartholomew pool

10" @ 160' Drlg. 918

J. E. TYRA

Scout Cards *mm*  
Land Small Map.....  
Land Wall Map *3*  
Tracings  
France Map.....  
Pierce Map.....  
Misc.....

SEP 21 1951

Orig. Data

County Sedgwick State Kansas

Sec. 30 (Blk. Twp.) 27 (Sur. Rge.) 4W Map No.

Operator Kingwick Oil & Gas

Well No. 3 Farm Bartholomew

Elev. 1425 Location C E $\frac{1}{2}$  E $\frac{1}{2}$  SW


**COMPLETE**

1320 Ft. From S Line SW

320 Ft. From E Line Quarter

1st. Report

Completion AUG 27 1952

Remarks Bartholomew Pool

Sterling Drlg. - Contr.

Spudding Date 9-15-51

Drlg. Data Oil well TD 3751

10" @ 160 Lans. 2884 DST 3296-3305

open 1 hr. Rec. 20' mud & water & SSO &

gas Miss. dol. 3737 5" @ 3737 TD 3751

F/ 35 bopd Comp. 10 bopd

Scout Cards	.....
Land Small Map	.....
Land Wall Map	.....
Tracings	.....
France Map	.....
Pierce Map	.....
Misc.	.....

SEP 3 1952

Dirg. Data