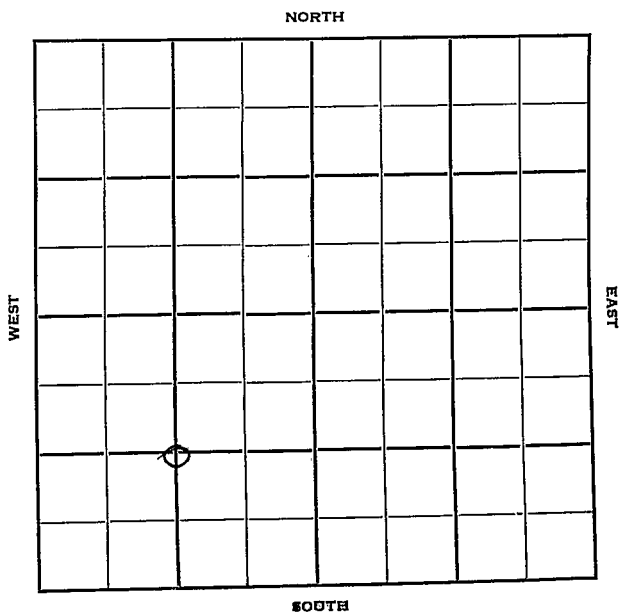


Section 30 Township 27 Range 4WWell No. #4 BartholomewCompany Kingwick Oil

Sedgwick

KANSAS

Sec. 30 Twp. 27 R. 4 W

Well No. # 4 Bartholomew Farm

Sedgwick Oil Company

Sterling Drlg. Contractor
Bartholomew Pool


 Ft. from N. Line

1320 Ft. from S. Line

 Ft. from E. Line

1320 Ft. from W. Line

C SW/4

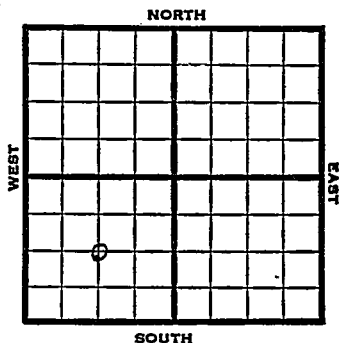


1951 Elev. 1427' REPORT

10/3 Spud 9-30-51
8" @ 160 WOC

1952
1/30 Spud 9-30-51
Oil Well TD 4141
8" @ 160
KC 2868
DST 3213-20 opn 1 hr. Rec. 35' mud
& sw DST 3240-47 opn 1 hr.
Rec. 90' oil & gcm & sw
DST 3270-98 opn 1 hr. Rec. 2400' gas
25' o&gcm 100' mco Miss 3712
DST 3757-65 opn 1 hr. Rec. 50' so&
gcm Misener 4075 Simp dol. 4116
Sand 4120 TD 4141 5" @ 3350
22/3370-80 500 A S/60 bw 9 bo 5 hr.
s/15 bo 96 bwpd Comp. 2 bopd
90% wtr.

COMPLETED

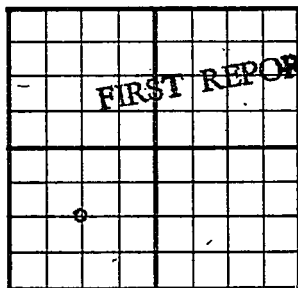County Sedgwick State KansasSec. 30 (Blk.) 27 (Sur.) 4W Map No.Operator Kingwick OilWell No. 4 Farm BartholomewElev. Location C SW/41320 Ft. From S Line SW1320 Ft. From W Line Quarter1st. Report OCT 3 1951

Completion

Remarks

Sterling Drlg. - Contr.Spudding Date 9-30-51Drlg. Data Bartholomew Pool8" @ 160 WOC

J. E. TYRA

OCT 5 1951

Scout Cards *mm*

Land Small Map

Land Wall Map *B*

Tracings

France Map

Pierce Map

Misc.


Drig. Data

County Sedgwick State Kansas
 Sec. 30 (^{Blk.}Twp.) 27 (^{Sur.}Rge.) 4W Map No.

Operator Kingwick Oil

Well No. 4 Farm Bartholomew

Elev. 1427 Location C Sw/4

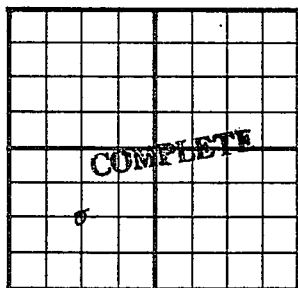

1320 Ft. From S Line SW

1320 Ft. From W Line Quarter

1st. Report

Completion JAN 30 1952

Remarks Bartholomew Pool

Sterling Drlg. - Contr.

Spudding Date 9-30-51

Drlg. Data Oil well TD 4141

8" @ 160' KC 2868 DST 3213-20

open 1 hr. Rec. 35' mud & sw DST 3240-

47 open 1 hr. Rec. 90' oil & gcm & sw

DST 3270-98 open 1 hr. Rec. 2400' gas

25' o & gcm 100' mco Miss. 3712

DST 3757-65 open 1 hr. Rec. 50' so &

gcm Misener 4075 Simp. dol. 4116

Sand 4120 TD 4141 5" @ 3350

22/ 3370-80 500 A S/ 60 bw 9 bo 5 hr

S/ 15 bo 96 bwpd

Comp. 2 bopd 90% water

J. G. McGEHEE

1952

Scout Cards	
Land Small Map	
Land Wall Map	
Tracings	
France Map	
Pierce Map	
Misc.	

Drig. Data