
FORM 51 25M 3-49 PETROL KANSAS Sedgwick

Section 30 Township 27 Range 4W

Well No. 3 Durfee

Company Cities Service

Bartholomew Pool

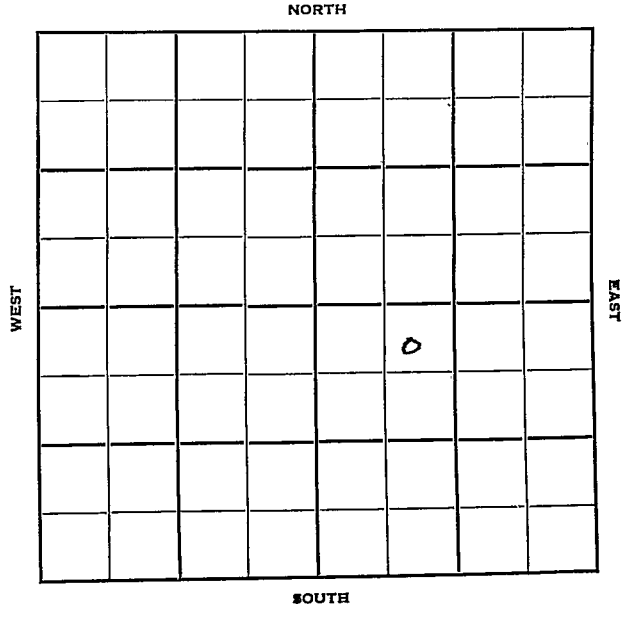

FORM 252-A
5M 10-48 PETROL

Sedgwick KANSAS

Sec. 30 Twp. 27 R. 4W

Well No. #3 Durfee Farm

Cities Service Company

Bartholomew Pool (Johnson, Cornish)


330' Ft. from N. Line

_____ Ft. from S. Line

_____ Ft. from E. Line

990' Ft. from W. Line

NE NW SE

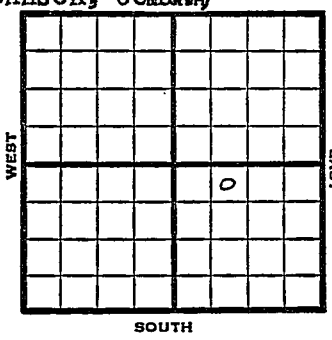


| 1949 | Elev 1435' REPORT |
|---|---|
| 9/21 | Location |
| 9/28 | 8"@ 221' |
| | Drlg 2350' |
| 10/5 | Drlg 3577' |
| 10/12 | Miss 3713' |
| | TD 3758' |
| | 5"@ 3730' |
| 10/19 | Flow 9 Oil PH |
| 10/26 | " |
| 11/2 | TD 3758' |
| | Miss 3713' |
| | 5"@ 3730' |
| | Flow 290 Oil Pot |
| | 39° Gr. |
| | Comp |

COMPLETED

Form 26 200 Bks. 6-49 Petrol

Kansas

Bartholomew Pool

Map No. _____ Sec. 30 Twp. 27 R. 4W


Well No. 3 Durfee

Cities Service Company

Johnson Contractor

NE NW SE

FIRST REPORT
SECTION PLAT

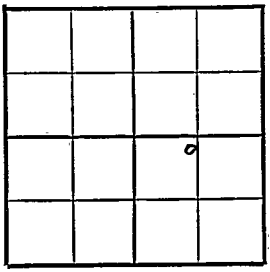

330 Ft. from N. Line

_____ Ft. from S. Line

_____ Ft. from E. Line

990 Ft. from W. Line

Sedgwick County

Location X

Rig up _____

Drilling and Remarks:

RECORD

Cased _____ in., _____ ft.

Sand _____

Gas _____

Oil _____

Total Depth _____

PRODUCTION

1st 24 hrs. Nat. _____

1st 24 hrs. after shot _____

Gas _____ Cu. Ft.

Dry Hole _____

Abandoned _____

Date

SEP 21 1949 19 S. J. LEWIS Scout

Form 26 200 Bks. 6-49 Petrol

Kansas

Bartholomew Pool

Map No. ____ Sec. 30 Twp. 27 R. 4W

Well No. 3 Durfee

Cities Service Company


COMPLETE

Contractor

NE NW SE

El. 1435

SECTION PLAT

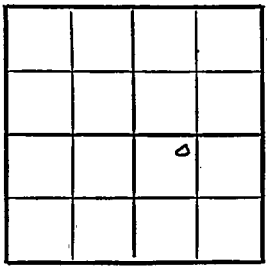

330 Ft. from N. Line

____ Ft. from S. Line

____ Ft. from E. Line

990 Ft. from W. Line

Sedgwick County

Location

Rig up

Drilling and Remarks:

Main 3713

5" @ 3730

Flow 290 bbls Oil

99° Gr

RECORD

Cased ____ in., ____ ft.

Sand

Gas

Oil

Total Depth 3765

PRODUCTION

1st 24 hrs. Nat.

1st 24 hrs. after shot

Gas ____ Cu. Ft.

Dry Hole

Abandoned

Date

NOV 2 1949 19 S. J. LEWIS Scout