


Section 30 Township 27 Range 4-W

Well No. #1 Berk "B"

Company Huber & Prime Drlg.

NORTH

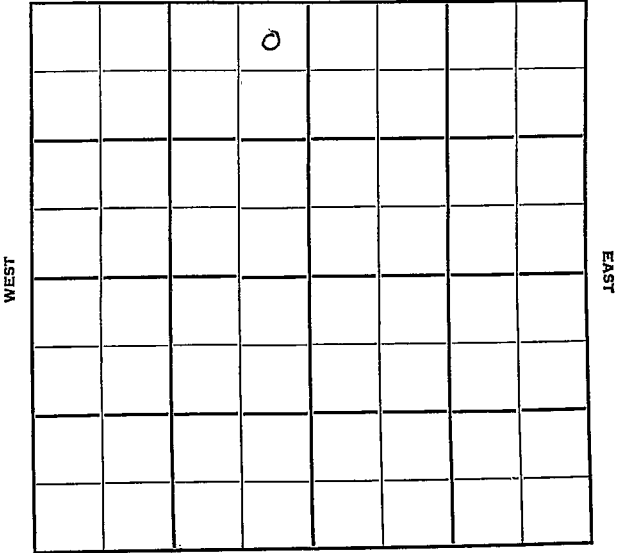

SOUTH

Sec. 30 Twp. 27 R. 4-W 1

Well No. #1 Berk "B" Farm _____

Huber & Prime Drlg. Company _____

Prime Drlg. Contractor _____

Battholomew


330 Ft. from N. Line

_____ Ft. from S. Line

330 Ft. from E. Line

_____ Ft. from W. Line

NE NE NW

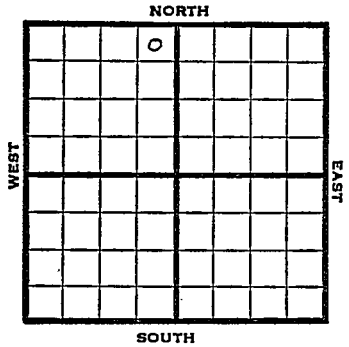

1950 Elv. 1461' REPORT

7/26 8" @ 201
SD 945

9/13 Oil Well TD 3807'
8" @ 201' Br. Lime 2888'
Lans. 2915' Miss 3743'
Dol. 3793-3801'
5" @ 3793' TD 3807'
1000 A B/19 BW 10 BO 17 hr.
30 qt. 3796-3807 S/34 BO 38 BW 13 hr.
Comp. 91 BOPD 20% wtr.

COMPLETED

Map No. _____ Sec. 30 Twp. 27 R. 4W

Well No. 1 Berk "B"

Huber & Prime Drlg. Company

Prime Drlg. Contractor

NE NE NW

330 Ft. from N. Line

_____ Ft. from S. Line

330 Ft. from E. Line

_____ Ft. from W. Line

SECTION PLAT



Wedgevic County

Location _____

Rig up _____

Drilling and Remarks:

8" @ 201

SD @ 945

RECORD

Cased _____ in., _____ ft.

Sand _____

Gas _____

Oil _____

Total Depth _____

PRODUCTION

1st 24 hrs. Nat. _____

1st 24 hrs. after shot _____

Gas _____ Cu. Ft.

Dry Hole _____

Abandoned _____

Date

JUL 26 1950 19

J. E. TYRA Scout

County Sedgwick State Kansas

Sec. 30 (Blk.) 27 (Sur.) 4W Map No.

Operator Huber & Prime Drlg.

Well No. 1 Farm Berk "B"

Elev. 1461 Location NE NE NW

		0			

330 Ft. From N Line NW

330 Ft. From E Line Quarter

1st. Report

Completion SEP 13 1950

Remarks

Bartholomew Pool

Spudding Date

Drlg. Data Oil well TD 3807

8" @ 201 Br. lime 2888 Lans. 2915

Miss. 3743 Dol. 3793-3801 5" @ 3793

TD 3807 1000 A B/ 19 bw 10 bo 17 hr.

30 qt. 3796-3807 S/ 34 bo 38 bw 13 hr.

Comp. 91 bopd 20% water

J. E. TYRA