FORM 51 25M 3-49 PETROL

KANSAS

Section 30 Township 27 Range 4W

Well No. #5 Durfee

Company Cities Service

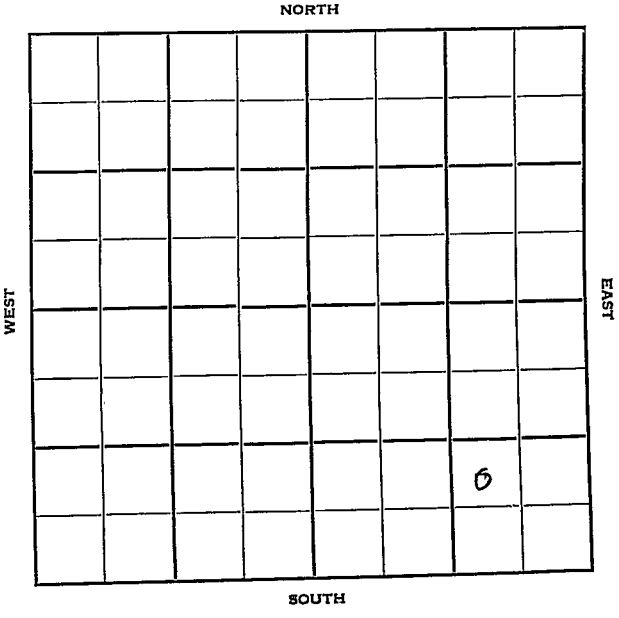

FORM 252-A
5M 10-48 PETROL

Sedgwick KANSAS

Sec. 30 Twp. 27 R. 4W

Well No. #5 Durfee Farm

Cities Service Company

Bartholomew Pool (RineDrlg, Contr.)

_____ Ft. from N. Line

990' Ft. from S. Line

990' Ft. from E. Line

_____ Ft. from W. Line

NW SE SE

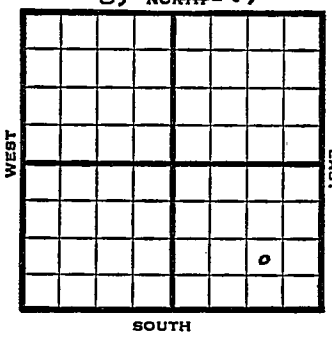

1949	Elev 1417' REPORT
12/14	8" @ 210'
12/21	Drlg 2835'
12/28	Lansing 2882'
	Miss 3715'
	Drlg 3735'
1950	
2/15	TD 3760'
	8"@ 210'
	5"@ 3726'
	Miss 3715'
	P 25 BOPD
	Comp

COMPLETED

Form 26 200 Bks. 6-49 Petrol

Kansas

Bartholomew Pool

Map No. ____ Sec. 30 Twp. 27 R. 4W

Well No. 5 Durfee

Cities Service Company

Rine Drlg. Contractor

NW SE SE

FIRST REPORT

SECTION PLAT

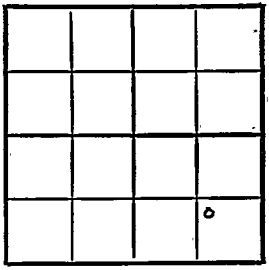

____ Ft. from N. Line

990 Ft. from S. Line

990 Ft. from E. Line

____ Ft. from W. Line

Sedgwick County

Location ____

Rig up ____

Drilling and Remarks:

8" @ 210

RECORD

Cased ____ in., ____ ft.

Sand ____

Gas ____

Oil ____

Total Depth ____

PRODUCTION

1st 24 hrs. Nat. ____

1st 24 hrs. after shot ____

Gas ____ Cu. Ft.

Dry Hole ____

Abandoned ____

Date

DEC 14 1949 19

S. J. LEWIS Scout

Form 26 200 Bks. 11-49 Petrol

Kansas

Bartholomew

Map No. _____ Sec. 30 Twp. 27 R. 4W

Well No. 5 Durfee

Cities Service Company

_____ Contractor

NW SE SE

El. 1417

SECTION PLAT

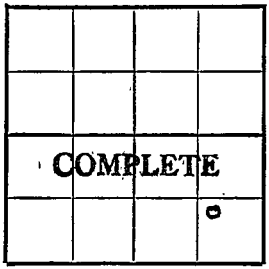

_____ Ft. from N. Line

990 Ft. from S. Line

990 Ft. from E. Line

_____ Ft. from W. Line

Sedgwick County

Location _____

Rig up _____

Drilling and Remarks:

8" @ 210

5" @ 3726

Miss 3715-

P 25 BOPD

RECORD

Cased _____ in., _____ ft.

Sand _____

Gas _____

Oil _____

Total Depth 3760

PRODUCTION

1st 24 hrs. Nat. _____

1st 24 hrs. after shot _____

Gas _____ Cu. Ft.

Dry Hole _____

Abandoned _____

Date

FEB 15 1950 19____

J. E. TYRA

_____ Scout