


Section 30 Township 27 Range 4 W

Well No. # 7 Durfee

Company Cities Service Oil

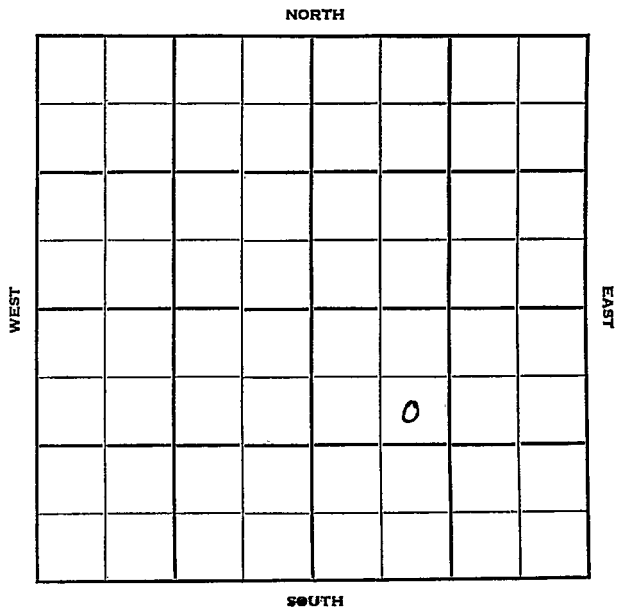

Sec. 30 Twp. 27 R. 4W

Well No. #7 Durfee Farm

Cities Service Oil Company

Barthelomew Contractor


990' Ft. from N. Line

 Ft. from S. Line

 Ft. from E. Line

990' Ft. from W. Line

SE NW SE

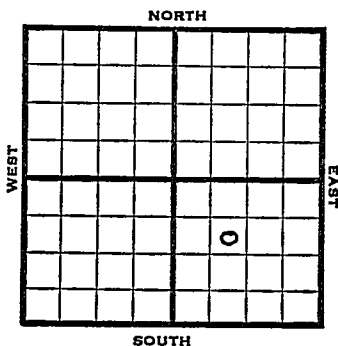


1951 Elev. 1425' REPORT

12/19 Spud 12-14-51
10₂ @ 198'

1952
1/23 Spud 12-14-51
D&A TD 1699
10" @ 198
Anhy 710 Her. 975 Win. 1027
Ft. Riley 2076 Wreford 1212
Cottonwood 1390
5" @ 1650 TD 1699
Test 50,000 CFG & Wtr.
D&A


ABANDONED

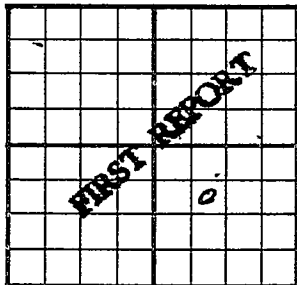County Sedgwick State KansasSec. 30 (Blk. Twp.) 27 (Sur. Rge.) 4W Map No.Operator Cities Service OilWell No. 7 Farm DurfeeElev. Location SE NW SE990 Ft. From N Line SE990 Ft. From W Line Quarter1st. Report DEC 1 9 1951

Completion

Remarks

Spudding Date 12-14-51Drig. Datar Barthelomew10" @ 198J. E. TYRA

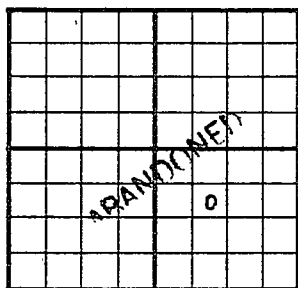County Sedgwick State KansasSec. 30 (Blk.
Twp.) 27 (Sur.
Rgs.) 4W Map No.Operator Cities Service OilWell No. 7 Farm DurfeeElev. 1425 Location SE NW SE990 Ft. From N Line SE990 Ft. From W Line Quarter1st. ReportCompletion JAN 23 1952Remarks Bartholomew PoolSpudding Date 12-14-51Drlg. Data D & A TD 169910" @ 198 Anhy 710 Her. 975Win. 1027 Ft. Riley 2076 Wreford 1212Cottonwood 1390 5" @ 1650 TD 1699test 50,000 cfg & waterD & A

J. G. McGEHEE