


Section 5 Township 27 Range 31W
Well No. 1 Wetig
Company BILL GRAHAM
J. W. Cleaver Oil

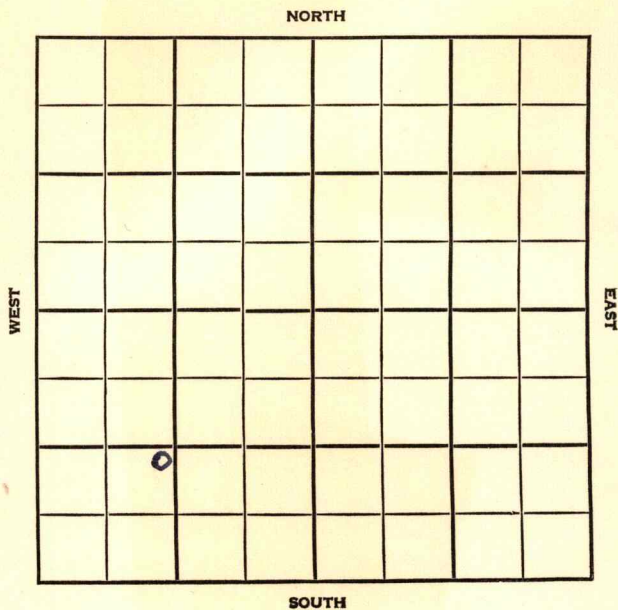

Haskell KANSAS


SEC.	TWP.	R.
5	27	31W
WELL NO.		
1 Wetig		FARM
COMPANY		
Bill GRAHAM J. W. Cleaver Oil		
CONTRACTOR		

_____ Ft. from N. Line

1250 _____ Ft. from S. Line

_____ Ft. from E. Line

1250 _____ Ft. from W. Line

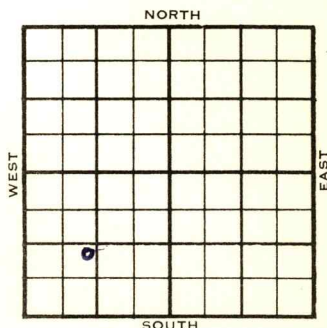NE SW SW
CSO FO

	ELEVATION	REPORT
1954	2830'	

11/10

Spud 11-6-54
8" @ 509', WOC

12/29

Spud 11-6-54 - Gas Well

TD 2710'

8" @ 509'

Kri 2648'

TD 2710'

4½" @ 2709'

CO

56/2648-62, 48/2672-84, frac
Comp. 6,125,000 c fgp**COMPLETED**

County **Haskell** State **Kansas**

Sec. 5 (Blk.) 27 (Sur.) 31W Map No.

Operator J. W. Cleaver Oil

Well No. **1** Farm **Wetig**

Elev. 2830 Location NE SW SW

[illegible]

1250 Ft. From S Line SW

1250 Ft. From W Line Quarter

1st. Report

Completion

Remarks CSO farmout

Spudding Date 11-6-54

Drlg. Data

8" @ 509 WOC

FABEN GILSTRAP

Map No. _____ Sec. 5 Twp. 27 R. 31WWell No. 1 Wetig_____
Bill Graham Company

CORRECTION

Contractor

NE S WSW

SECTION PLAT

o			

Ft. from N. Line1250 Ft. from S. Line_____
Ft. from E. Line1250 Ft. from W. LineHaskell County

Location _____

Rig up _____

Drilling and Remarks:

Reported

J. W. Cleaver Oil

RECORD

Cased _____ in., _____ ft.

Sand _____

Gas _____

Oil _____

Total Depth _____

PRODUCTION

1st 24 hrs. Nat. _____

1st 24 hrs. after shot _____

Gas _____ Cu. Ft.

Dry Hole _____

Abandoned _____

Date

NOV 23 1954FABEN OIL STRAP Scout

County **Haskell** State **Kansas**

Sec. 5 (Blk. Twp.) 27 (Sur. Rge.) 31W Map No.

Operator Bill Graham

Well No. 1 Farm Wetig

Elev.	2830	Location	NE SW SW
-------	------	----------	----------

COMPLETE

1250 Ft. From S Line SW

1250 Ft. From W Line Quarter

1st. Report

Completion DEC 29 1954

Remarks

Spudding Date 11-6-54

Drig. Data Gas well TD 2710

8" @ 509 Kri. 2648 TD 2710 4 $\frac{1}{2}$ " @ 2709

CO 56/ 2648-62 48/ 2672-84 frac

Comp. 6,125,000 c/gpd

FABEN GILSTRAP