

Sec. 31 Twp. _____ R. _____

Well No. #1 Lorenz Farm _____

Cities Service Company _____

Rine Drlg. Contractor _____


Bartholomew
330' Ft. from N. Line

_____ Ft. from S. Line

990' Ft. from E. Line

_____ Ft. from W. Line

NW NE NE

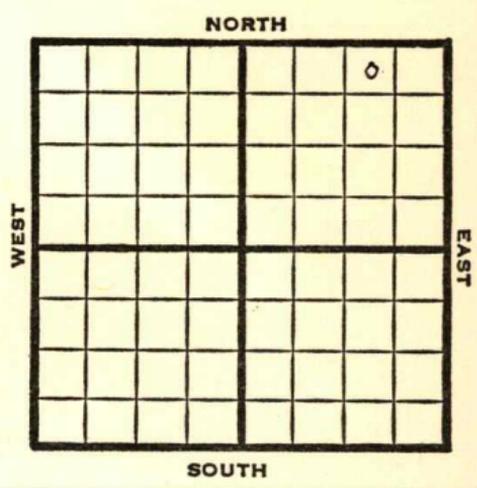

1950

Elev 1413' REPORT

3/8
4/5

RUR
TD 3754'
8"@ 203'
Lans 2870'
Miss 3704'
Pay 3741-51
Flow 539'
BOPD
Comp

COMPLETED

Kansas

Map No. _____ Sec. 31 Twp. 27 R. 4W

Well No. 1 Lorenz

Cities Service Company

Rine Drlg. Contractor

NW NE NE

SECTION PLAT



330 Ft. from N. Line

_____ Ft. from S. Line

990 Ft. from E. Line

_____ Ft. from W. Line

Sedgwick County

RECORD

Location _____

Cased _____ in., _____ ft.

Rig up _____

Sand _____

Drilling and Remarks:

Gas _____

Oil _____

R U R

Total Depth _____

PRODUCTION

1st 24 hrs. Nat. _____

1st 24 hrs. after shot _____

Gas _____ Cu. Ft.

Dry Hole _____

Abandoned _____

Date

MAR 8 1950

J. E. TYRA

19

Scout

Map No. _____ Sec. 31 Twp. 27 R. 4W

Well No. 1 Lorenz

Cities Service Company

Contractor

NW NE NE

EI. 1413
SECTION PLAT

330 Ft. from N. Line

_____ Ft. from S. Line

990 Ft. from E. Line

_____ Ft. from W. Line



Sedgwick County

Location _____

Rig up _____

Drilling and Remarks:

8" @ 203
Lans 2870
Miss 3704
pay 3741-51
flaw 539
BOPD

RECORD

Cased _____ in., _____ ft.

Sand _____

Gas _____

Oil _____

Total Depth 3754

PRODUCTION

1st 24 hrs. Nat. _____

1st 24 hrs. after shot _____

Gas _____ Cu. Ft.

Dry Hole _____

Abandoned _____

Date

APR 5 1950

J. E. TYRA

Scout