


Section 31 Township 27 Range 4-W

Well No. #2 Durfee "B"

Company Cities Service

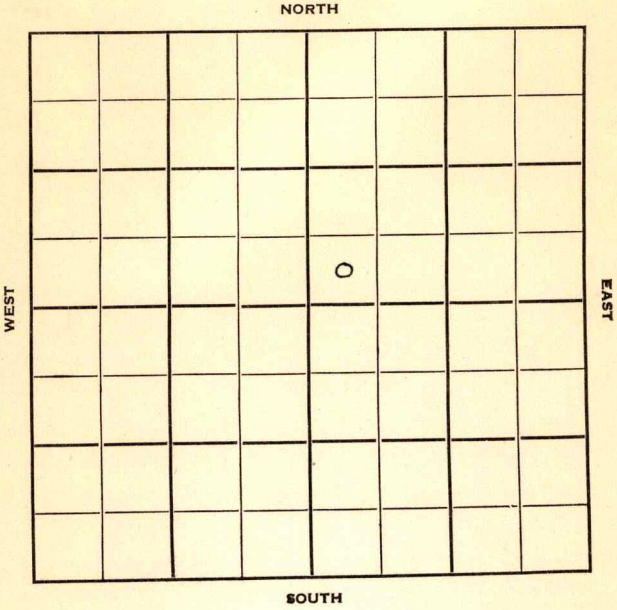

31

27

4W

Sec. \_\_\_\_\_ Twp. \_\_\_\_\_ R. \_\_\_\_\_

#2 Durfee "B"

Well No. \_\_\_\_\_ Farm \_\_\_\_\_

Cities Service

Company \_\_\_\_\_

Rine Drlg.

Contractor \_\_\_\_\_

\_\_\_\_\_ Ft. from N. Line

330'


\_\_\_\_\_ Ft. from S. Line

\_\_\_\_\_ Ft. from E. Line

330'

\_\_\_\_\_ Ft. from W. Line

SW SW NE

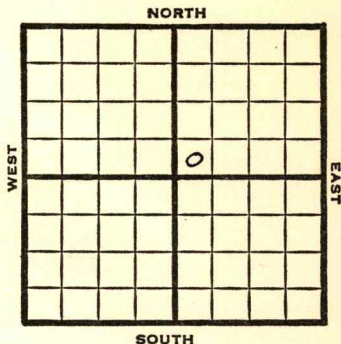

1950

REPORT

6/28

Spud 6-23-50  
8" @ 204'  
Drlg. 2110'

1952

2/6

No Report

2/-

Spud 6-23-50  
Oil Well TD 3741'  
8" @ 204 Br Li 2835 Lans. 2878  
Miss. 3687' Dol. 3723-31  
5" @ 3706 TD 3741 1000 A  
F/ 264 bo 12 hr.  
Comp. BHB 1120 bopd

COMPLETED

Kansas

Map No. \_\_\_\_\_ Sec. 31 Twp. 27 R. 4W

Well No. 2 Durfee "B"

Cities Service Company

Rine Drlg. Contractor

SW SW NE

SECTION PLAT

		0	

\_\_\_\_\_ Ft. from N. Line

330

\_\_\_\_\_ Ft. from S. Line

\_\_\_\_\_ Ft. from E. Line

330

\_\_\_\_\_ Ft. from W. Line

FIRST REPORT

Sedgwick County

Location \_\_\_\_\_

Rig up \_\_\_\_\_

Drilling and Remarks:

Spud 6-23-50

8" @ 204

drlg. 2110

RECORD

Cased \_\_\_\_\_ in., \_\_\_\_\_ ft.

Sand \_\_\_\_\_

Gas \_\_\_\_\_

Oil \_\_\_\_\_

Total Depth \_\_\_\_\_

PRODUCTION

1st 24 hrs. Nat. \_\_\_\_\_

1st 24 hrs. after shot \_\_\_\_\_

Gas \_\_\_\_\_ Cu. Ft.

Dry Hole \_\_\_\_\_

Abandoned \_\_\_\_\_

Date

JUN 28 1950 19

J. E. TYRA

Scout

