
Sedgwick KANSAS

FORM 51 25M 3-49 PETROL

Section 31 Township 27 Range 4W

Well No. #2 Lorenz

Company Cities Service

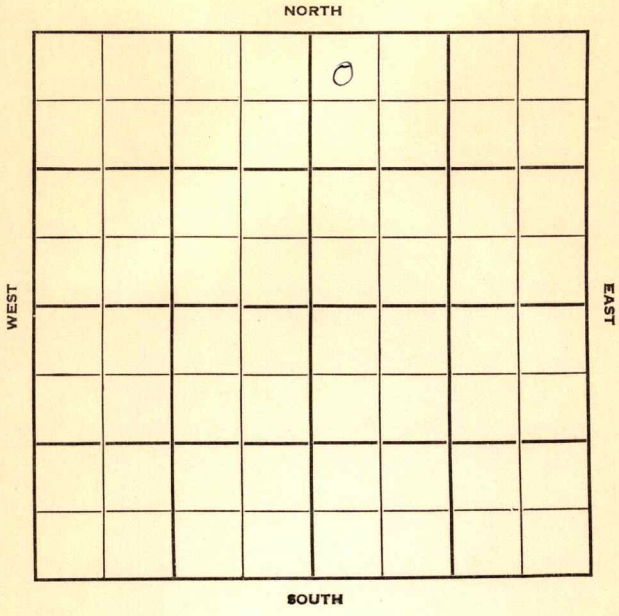

FORM 252-B
10M 9-49 PETROL

Sedgwick

KANSAS

Sec. 31 Twp. 27 R. 4W

Well No. #2 Lorenz Farm

Cities Service Company

Rine Drlg. Contractor

Bartholomew Pool


330' Ft. from N. Line

_____ Ft. from S. Line

_____ Ft. from E. Line

330' Ft. from W. Line

NW NW NE

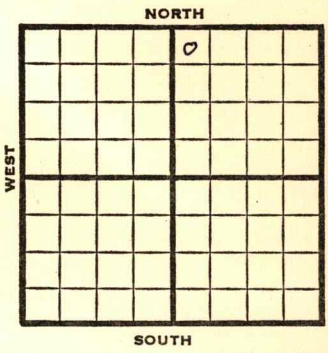

1950	Elev. 1410' REPORT
4/12	Spud 4-6-50 12" @ 195' 8" @ 335' Drlg. 1310'
5/10	TD 3747 12" @ 195 8" @ 335 Miss 3688 5" @ 3705 1748 BOPD Completed

COMPLETED

Form 26 200 Bks. 11-49 Petrol

Kansas Bartholomew Pool

Map No. ____ Sec. 31 Twp. 27 R. 4W

Well No. 2 Lorenz


Cities Service Company

Rine Drlg. Contractor

NW NW NE

El. 1410

SECTION PLAT

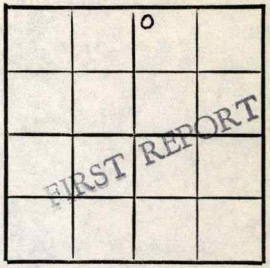

330 Ft. from N. Line

____ Ft. from S. Line

____ Ft. from E. Line

330 Ft. from W. Line

Sedgwick County

Location ____

Rig up ____

Drilling and Remarks:

Spud 4-6-50

12" @ 195

8" @ 335

drlg. 1310

RECORD

Cased ____ in., ____ ft.

Sand ____

Gas ____

Oil ____

Total Depth ____

PRODUCTION

1st 24 hrs. Nat. ____

1st 24 hrs. after shot ____

Gas ____ Cu. Ft.

Dry Hole ____

Abandoned ____

Date

APR 12 1950 19____ J. E. TYRA Scout

Form 26 200 Bks. 11-49 Petrol

Kansas

Bartholomew Pool

Map No. _____ Sec. 31 Twp. 27 R. 4W

Well No. 2 Lorenz


Cities Service Company

Contractor

NW NW NE

El. 1410

SECTION PLAT

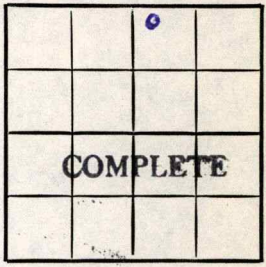

330 Ft. from N. Line

Ft. from S. Line

Ft. from E. Line

330 Ft. from W. Line

Sedgwick

Location

Rig up

Drilling and Remarks:

12" @ 195

8" @ 3355

Miss 3688

5" @ 3705

1748 BOPD

RECORD

Cased _____ in., _____ ft.

Sand

Gas

Oil

Total Depth 3747

PRODUCTION

1st 24 hrs. Nat.

1st 24 hrs. after shot

Gas _____ Cu. Ft.

Dry Hole

Abandoned

Date

MAY 10 1950

19

J. E. TYRA Scout