

KANSAS


Grant

Section 31 Township 27 Range 38WWell No. 1 J. JungfurmanCompany Western Natural Gas

Hugoton

NORTH

WEST

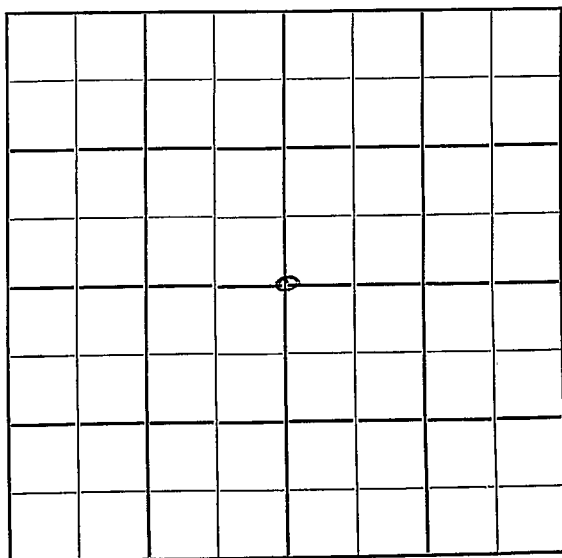

EAST

- SOUTH

Grant

KANSAS

Sec. 31 Twp. 27 R. 38W

Well No. #1 J. Jungfurman Farm

Western Natural Gas Company

Hugoton Pool


2640' Ft. from N. Line

Ft. from S. Line

2640' Ft. from E. Line

Ft. from W. Line

C Sec.

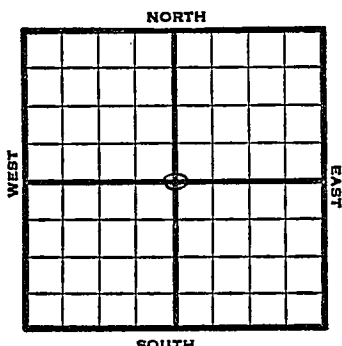

1949 Elev. 3135 DF REPORT

9/21	10" @ 674'
	Drlg. 1255'
9/28	"
10/5	7" @ 2403'
	Drlg 2404'
10/12	"
10/19	TD 2404'
	18000 acid
10/26	"
11/1	"
11/9	"
11/16	"
11/23	"
11/29	"
12/7	"
12/14	254' of 5" Perf liner @ 2650'
12/21	"
12/28	"
1950	
1/11	TD 2650'
	10" @ 674'
	7" @ 2403'
	254' 5" liner
	Hev 2300
	Kr 2336'
	Win 2396'
	Ft Riley 2500
	Comp open flow
	7,450,000 MCFGPD
	Rock Press 417#

COMPLETED

Map No. _____ Sec. 31 Twp. 27 R. 38W

Well No. 1 J. Jungfurman

Western Natural Gas Company

Contractor

C Sec.


FIRST REPORT
SECTION PLAT

2640 Ft. from N. Line

_____ Ft. from S. Line

2640 Ft. from E. Line

_____ Ft. from W. Line

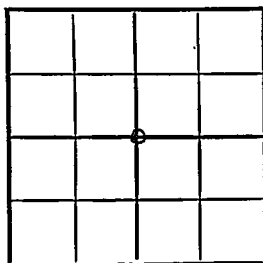

Grant County

Location _____

Rig up _____

Drilling and Remarks:

10" @ 674

drlg. 1255

RECORD

Cased _____ in., _____ ft.

Sand _____

Gas _____

Oil _____

Total Depth _____

PRODUCTION

1st 24 hrs. Nat. _____

1st 24 hrs. after shot _____

Gas _____ Cu. Ft.

Dry Hole _____

Abandoned _____

Date

SEP 21 1949 19

S. J. LEWIS Scout

Map No. _____ Sec. 31 Twp. 27 R. 38WWell No. 1 J. Hungfurman

Western Natural Gas Company

C Sec. _____


Contractor

E. L. 3135
SECTION PLAT2640 Ft. from N. Line

_____ Ft. from S. Line

2640 Ft. from E. Line

_____ Ft. from W. Line

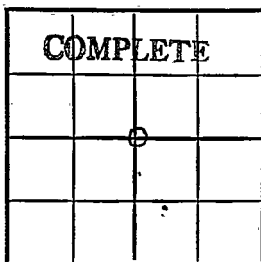

Grant County

Location _____

Rig up _____

Drilling and Remarks:

10" @ 674
 7" @ 2403
 254' 5" liner
 Rv 2300
 Rv 2336
 Win 2396
 Ft. Rty 2500

Date _____

(over)

RECORD

Cased _____ in., _____ ft.

Sand _____

Gas _____

Oil _____

Total Depth 2650

PRODUCTION

1st 24 hrs. Nat. _____

1st 24 hrs. after shot _____

Gas _____ Cu. Ft.

Dry Hole _____

Abandoned _____

JAN 11 1950 19

J. E. TYRA Scout