


Section 31 Township 27 Range 35W

Well No. #1 Fretz

Company Columbian Fuel

Hugoton Pool NORTH

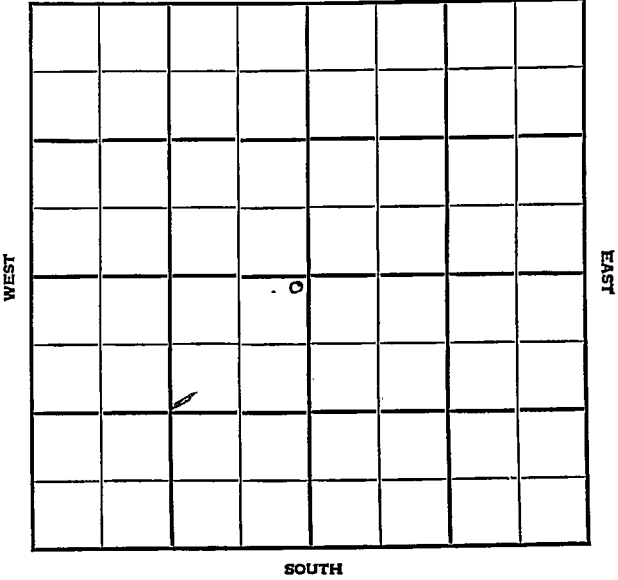



Sec. 31 Twp. 27 R. 35W

Well No. #1 Fretz Farm

Columbian Fuel Company

Hugoton Pool


100' Ft. from N. Line

_____ Ft. from S. Line

100' Ft. from E. Line

_____ Ft. from W. Line

NE SW

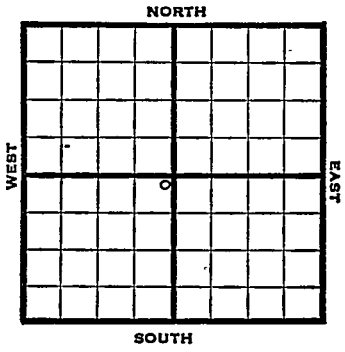

1948 Elev. 3117' REPORT

- 3/31 Location
- 4/7 RUR
- 4/14 10" @ 640'
Drlg. 2100'
- 4/21 7" @ 2606'
TD 2607'
- 4/28 TD 2832'
246' of 5" perf. liner @ 2832'
- 5/5 Acid 15,000
- 5/12 7" @ 2606'
246' of 5" perf. liner @ 2832'
15,000 acid.
9,690,000 Gas.
419# R. Pr.
TD 2832'
Comp.

COMPLETED

Map No. _____ Sec. 31 Twp. 27 R. 35W

Well No. 1 Fretz

Columbian Fuel Company

FIRST REPORT

Contractor _____

NE SW

SECTION PLAT

100 Ft. from N. Line

_____ Ft. from S. Line

100 Ft. from E. Line

_____ Ft. from W. Line

		o	

Grant County

Location X

Rig up _____

Drilling and Remarks:

RECORD

Cased _____ in., _____ ft.

Sand _____

Gas _____

Oil _____

Total Depth _____

PRODUCTION

1st 24 hrs. Nat. _____

1st 24 hrs. after shot _____

Gas _____ Cu. Ft.

Dry Hole _____

Abandoned _____

Date

MAR 31 1948 19 _____ S. J. LEWIS Scout

Map No. _____ Sec. 31 Twp. 27 R. 35W

Well No. 1 Fretz

_____ Columbian Fuel _____ Company

COMPLETE

_____ Contractor

NE SW

E1317
SECTION PLAT

100 Ft. from N. Line

_____ Ft. from S. Line

100 Ft. from E. Line

_____ Ft. from W. Line

		4	

Grant County

Location _____

Rig up _____

Drilling and Remarks:

7" @ 2606
246' of 5" Payline
@ 2882
15000 cu. ft.
9,690,000 Gas
418# R/P

RECORD

Cased _____ in., _____ ft.

Sand _____

Gas _____

Oil _____

Total Depth 2882

PRODUCTION

1st 24 hrs. Nat. _____

1st 24 hrs. after shot _____

Gas _____ Cu. Ft.

Dry Hole _____

Abandoned _____

Date

MAY 12 1948 19

S. J. LEWIS Scout