

KANSAS

Haskell

Section 31 Township 27 Range 34W

Well No. 1 Biggs


Company Columbian Fuel

Hugoton

NORTH

WEST

EAST

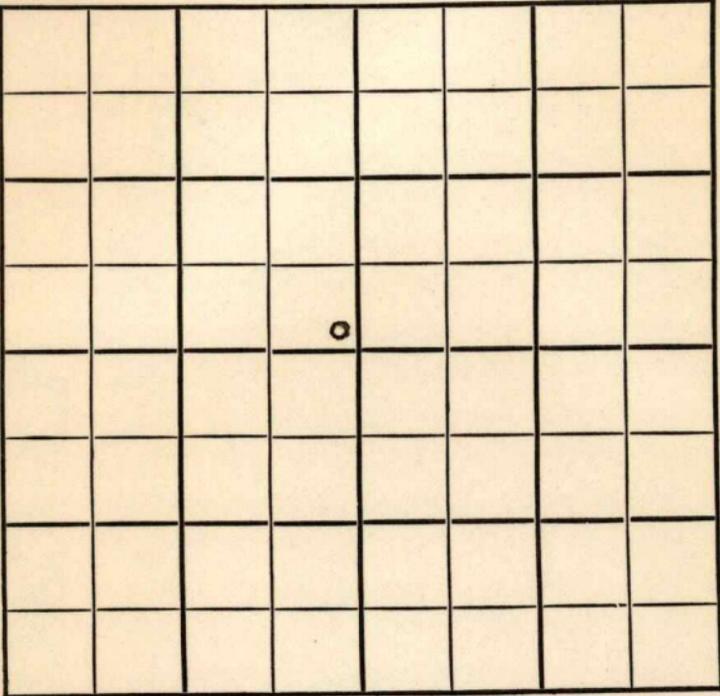


SOUTH

Sec. 31 Twp. 27 R. 34W

Well No. #1 Biggs Farm _____

Columbian Fuel Company
SE NW

_____ Ft. from N. Line
100 Ft. from S. Line
100 Ft. from E. Line
_____ Ft. from W. Line
SE NW

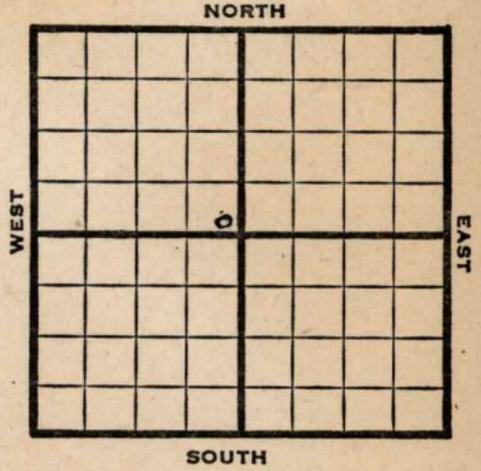

1947 **Elev. 3053' REPORT**

10/22 **RUR**

10/29 10" @ 600'
Drlg. 2510'

11/5 TD 2625'
7" @ 2609'
RUST

11/12 TD 2810'
207' of 5" Perf. Liner @ 2810'

11/19 "

11/26 "

12/3 "

12/10 15000 acid.

12/17 7" @ 2609'
207' of 5" perf liner
@ 2810'
15000 acid
15,696,000 Gas
412# RPr
TD 2870'

COMPLETED

Hugoton

Map No. _____ Sec. **31** Twp. **27** R. **34W**


Well No. **1 Biggs**

Columbian Fuel _____ Company

FIRST REPORT _____ Contractor

SE NW

SECTION PLAT

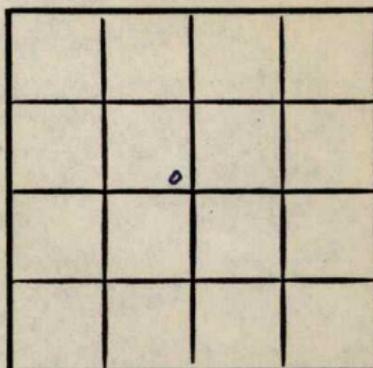

_____ Ft. from N. Line

100 Ft. from S. Line

100 Ft. from E. Line

_____ Ft. from W. Line

Haskell County

Location _____

Rig up _____

Drilling and Remarks:
RUR

RECORD

Cased _____ in., _____ ft.

Sand _____

Gas _____

Oil _____

Total Depth _____

PRODUCTION

1st 24 hrs. Nat. _____

1st 24 hrs. after shot _____

Gas _____ Cu. Ft.

Dry Hole _____

Abandoned _____

Date

OCT 22 1947 19 _____

S. J. LEWIS Scout

Map No. _____ Sec. 31 Twp. 27 R. 34W

Well No. 1 Biggs

Columbian Fuel Company

COMPLETE

Contractor

SE NW

E 13053

SECTION PLAT

_____ Ft. from N. Line

100 Ft. from S. Line

100 Ft. from E. Line

_____ Ft. from W. Line

Haskell County

Location _____

Rig up _____

Drilling and Remarks:

7" @ 2609
207' x 5" Prof line
@ 2870
15-000 @ acid
15,696,000 Gas
412 # R/A

RECORD

Cased _____ in., _____ ft.

Sand _____

Gas _____

Oil _____

Total Depth 2870

PRODUCTION

1st 24 hrs. Nat. _____

1st 24 hrs. after shot _____

Gas _____ Cu. Ft.

Dry Hole _____

Abandoned _____

Date _____

DEC 17 1947 19

S. J. LEWIS

Scout