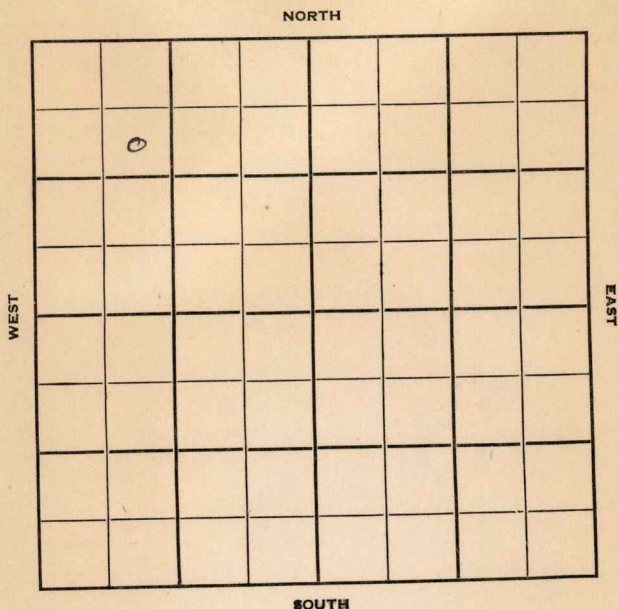


Section 31 Township 27 Range 4-WWell No. #3 LorenzCompany J M Huber Corp

Sec. 31 Twp. 27 R. 4W

Well No. #3 Lorenz Farm

J. M. Huber Corp. Company

Pabco Contractor

Bartholomew Pool


990' Ft. from N. Line

Ft. from S. Line

990' Ft. from E. Line

Ft. from W. Line

SW NE NW

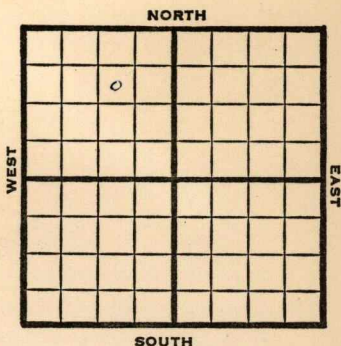

1950

Elev 1409

REPORT

4/5

Spud 3-31-50

13" @ 145'

Ddg. 325'

5/17

TD 3735

13" @ 145

Lans 2865

Miss 3687-3735

5" @ 3721

693 BOPD

6% wtr

Completed

COMPLETED

Kansas

Bartholomew Pool

Map No. _____ Sec. 31 Twp. 27 R. 4WWell No. 3 Lorenz_____
J. M. Huber Corp. Company_____
Pabco Contractor

SW NE NW

SECTION PLAT

990 Ft. from N. Line_____
Ft. from S. Line990 Ft. from E. Line_____
Ft. from W. Line

	0		

FIRST REPORT

Sedgwick County

Location _____

Rig up _____

Drilling and Remarks:

Spud 3-31-50

13" @ 145

drlg. 325

RECORD

Cased _____ in., _____ ft.

Sand _____

Gas _____

Oil _____

Total Depth _____

PRODUCTION

1st 24 hrs. Nat. _____

1st 24 hrs. after shot _____

Gas _____ Cu. Ft.

Dry Hole _____

Abandoned _____

Date

APR 5 1950 19J. E. TYRA Scout

Kansas

Map No. _____ Sec. 31 Twp. 27 R. 4WWell No. 3 LorenzJ. M. Huber Corp. Company

Contractor

SW NE NW

E1. 1409


SECTION PLAT

990 Ft. from N. Line

_____ Ft. from S. Line

990 Ft. from E. Line

_____ Ft. from W. Line

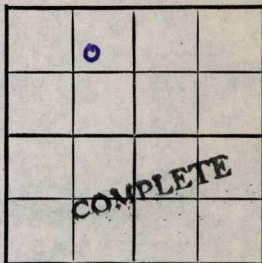

Sedgwick

Location _____

Rig up _____

Drilling and Remarks:

13" @ 145
 Land 2865
 miss 3687-3735
 5" @ 3721
 693 BOPD
 6% water

RECORD

Cased _____ in., _____ ft.

Sand _____

Gas _____

Oil _____

Total Depth 3735

PRODUCTION

1st 24 hrs. Nat. _____

1st 24 hrs. after shot _____

Gas _____ Cu. Ft.

Dry Hole _____

Abandoned _____

Date

MAY 17 1950

19

J. E. TYRA Scout