


Section 31 Township 27 Range 4-W

Well No. #4 Lorenz

Company Cities Service

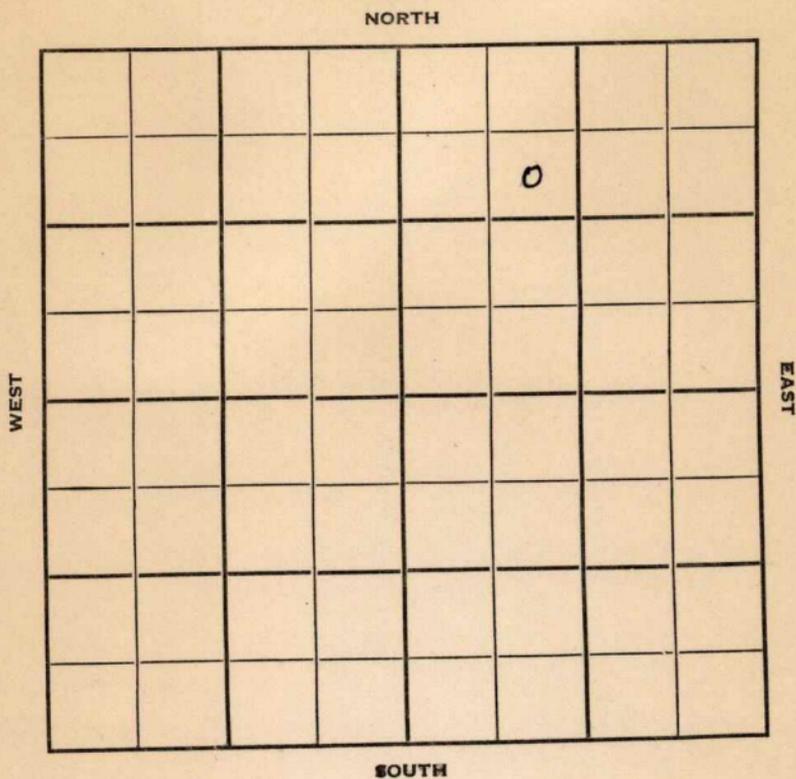

Sedgwick
27

KANSAS

4W ✓

Sec. 31 Twp. _____ R. _____

Well No. #4 Lorenz Farm _____

Cities Service

Company _____

Bartholomew Pool

Contractor _____


990' Ft. from N. Line

_____ Ft. from S. Line

_____ Ft. from E. Line

990' Ft. from W. Line

SE NW NE

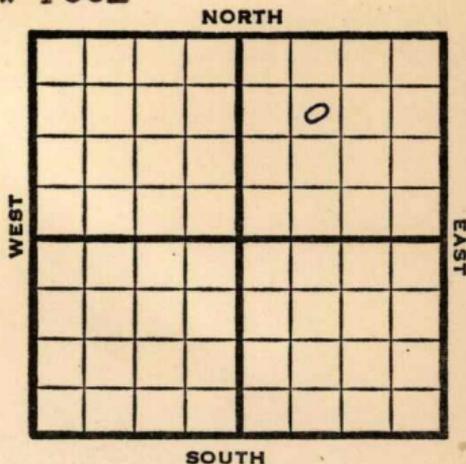

1950

Elev. 1405' REPORT

7/5

Location

9/13

Oil Well TD 3760'

8" @ 210'

Miss Chat 3686' Miss Dol. 3716-28

5" @ 3699' TD 3760'

2000 A F/158 BO 30 BW 16 hr.

Comp. 118 BO 35 BWPD

COMPLETED

Kansas

Map No. _____ Sec. 31 Twp. 27 R. 4W

Well No. 4 Lorenz

Cities Service Company

Contractor

SE NW NE

SECTION PLAT

990 Ft. from N. Line

_____ Ft. from S. Line

_____ Ft. from E. Line

990 Ft. from W. Line



Sedgwick County

Location X

Rig up _____

Drilling and Remarks:

RECORD

Cased _____ in., _____ ft.

Sand _____

Gas _____

Oil _____

Total Depth _____

PRODUCTION

1st 24 hrs. Nat. _____

1st 24 hrs. after shot _____

Gas _____ Cu. Ft.

Dry Hole _____

Abandoned _____

Date

JUL 5 1950 19

J. E. TYRA Scout

