

KANSAS

Kingman

FORM 51 5M 1-42 PETROL

Section 31 Township 27 Range 10-W

Well No. #1 Michener


Company Skelly

Semi-Wildcat

NORTH

WEST

EAST

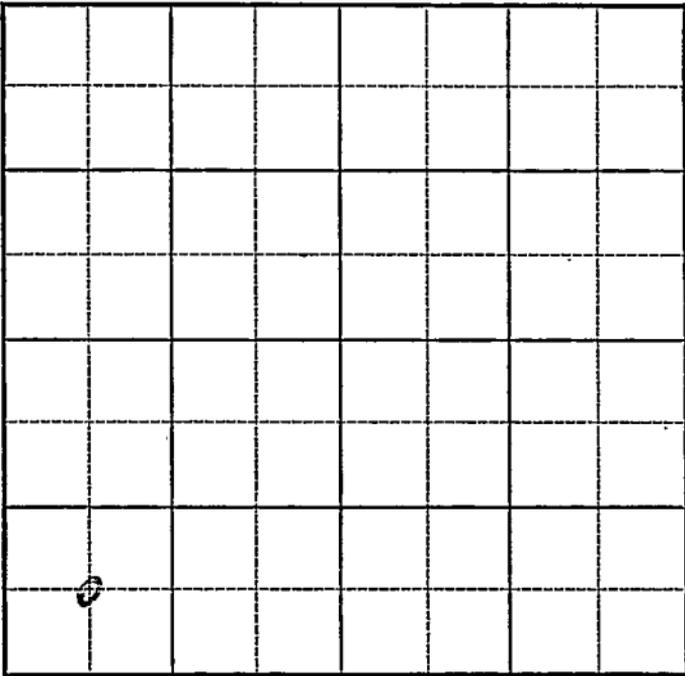

SOUTH

Map No. 54 Sec. 31 Twp. 27 R. 10W

Well No. 1 Michener

Skelly Company

FIRST REPORT Contractor

C SW SW

SECTION PLAT

_____ Ft. from N. Line

660 Ft. from S. Line

_____ Ft. from E. Line

660 Ft. from W. Line

o			

SEMI WILDCAT

Location _____

Rig up _____

Drilling and Remarks:

Rotary

RECORD

Cased _____ in., _____ ft.

Sand _____

Gas _____

Oil _____

Total Depth _____

PRODUCTION

1st 24 hrs. Nat. _____

1st 24 hrs. after shot _____

Gas _____ Cu. Ft.

Dry Hole _____

Abandoned _____

Date

MAR 4 1942 19

S. J. LEWIS Scout

Kingman

KANSAS

Map No. 54 Sec. 31 Twp. 27 R. 10WWell No. 1 MichenerSkelly CompanyABANDONED Contractor

C SW SW

 Ft. from N. Line660 Ft. from S. Line Ft. from E. Line660 Ft. from W. Line

SECTION PLAT

<u>b</u>			

SEMI WILDCAT

Location Rig up

Drilling and Remarks:

Vidwa 4245Noshows

RECORD

Cased in., ft.Sand Gas Oil Total Depth 4260

PRODUCTION

1st 24 hrs. Nat. 1st 24 hrs. after shot Gas Cu. Ft.Dry Hole Abandoned

Date

APR 1 1942 19S. J. LEWIS Scout