

KANSAS

Form 51-5M-7-39-Palace


Kingman

Section 31 Township 27 Range 10-W

Well No. #1 H. Steffen "A"

Company Skelly

NORTH Cunningham Pool

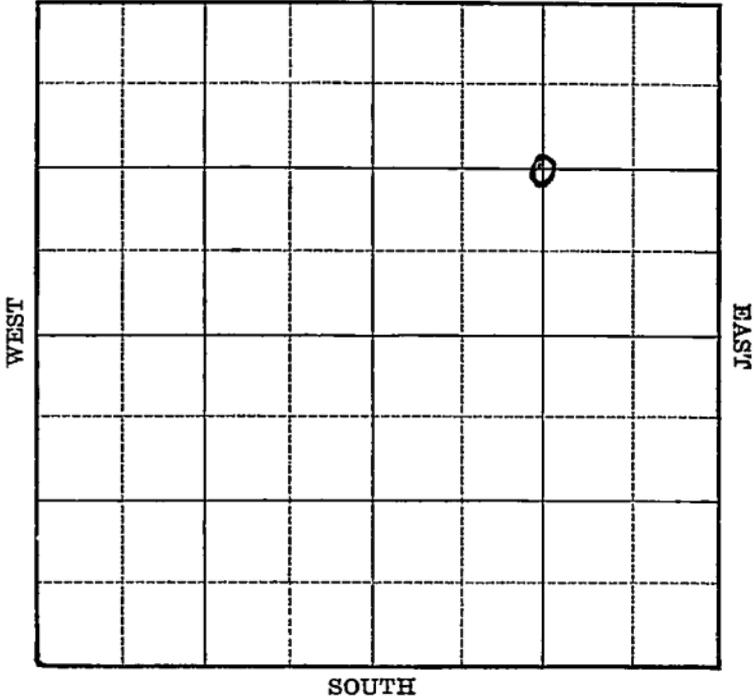

Sec. 31 Twp. 27 R. 10-W

Well No. #1 H. Steffen "A" Farm

Skelly Company

(Cunningham)


1325 Ft. from N. Line

_____ Ft. from S. Line

1320 Ft. from E. Line

_____ Ft. from W. Line

Elev. 1697

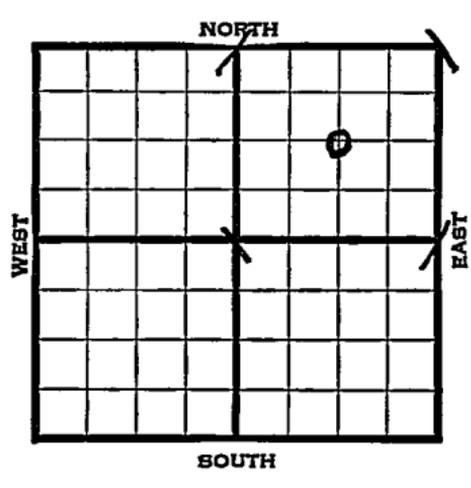


1939	REPORT
9/6	Location
9/14	10" - 350' Drlg. 490'
9/21	Drlg. 2610'
9/28	Lans. 3520' Drlg. 3650'
10/5	Miss. 4035' TD 4053' Fsg.
10/11	Viola 430 2 1/2'
	T.D. 4315'
	No shows.
	ABANDONED

Map No. 54 Sec. 31 Twp. 27 R. 10WWell No. 1 H. Steffen "A"Skelly Company

Contractor

FIRST REPORT

SECTION PLAT

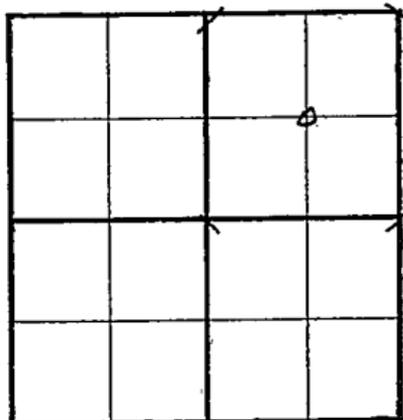C/NE
1325 Ft. from N. Line Ft. from S. Line1320 Ft. from E. Line Ft. from W. Line

CUNNINGHAM POOL

Location XRig up Drilling and Remarks:

RECORD

Cased in., ft.Sand Gas Oil Total Depth

PRODUCTION

1st 24 hrs. Nat. 1st 24 hrs. after shot Gas Cu. Ft.Dry Hole Abandoned

Date

SEP 6 1939 19 S. I. LEWIS Scout

Kingman **KANSAS**Map No. 54 Sec. 31 Twp. 27 R. 10WWell No. 1 H. Steffen "A"Skelly Oil

Company


Contractor

ABANDONED**C NE****SECTION PLAT**1325 Ft. from N. Line

_____ Ft. from S. Line

1320 Ft. from E. Line

_____ Ft. from W. Line

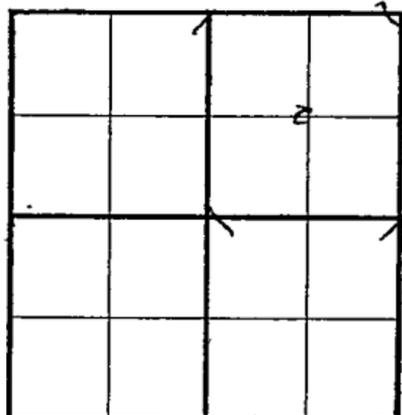CUNNINGHAM POOL

Location _____

Rig up _____

Drilling and Remarks:

*Viola 4302 1/2**No shows***RECORD**

Cased _____ in., _____ ft.

Sand _____

Gas _____

Oil _____

Total Depth 4315**PRODUCTION**

1st 24 hrs. Nat. _____

1st 24 hrs. after shot _____

Gas _____ Cu. Ft.

Dry Hole _____

Abandoned _____

Date

OCT 11 1939 19S. J. LEWIS Scout