
KANSAS Sedgwick

FORM 51 25M 3-49 PETROL

Section 31 Township 27 Range 4-W

Well No. #5 Davis

Company Westgate Greenland

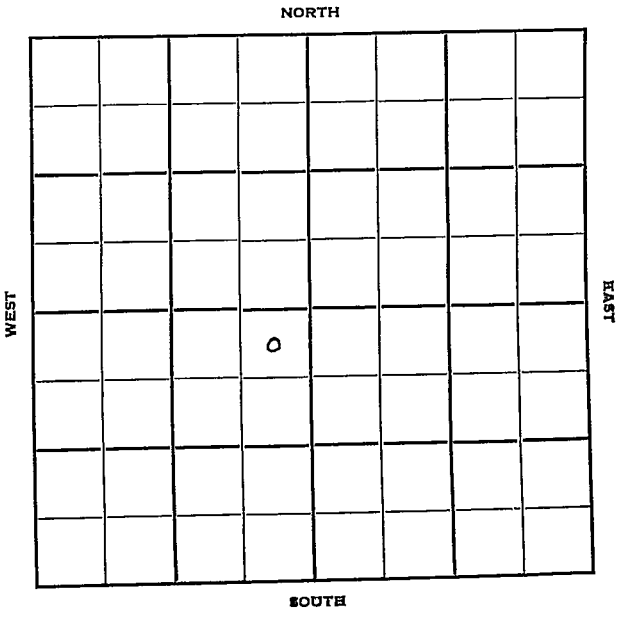

FORM 252-B
10M 9-49 PETROL

Sedgwick KANSAS

Sec. 31 Twp. 27 R. 4W

Well No. #5 Davis Farm

Westgate Greenland Company

Jackson
Barthlemew Contractor


330' Ft. from N. Line

Ft. from S. Line

330' Ft. from E. Line

Ft. from W. Line

NE NE SW

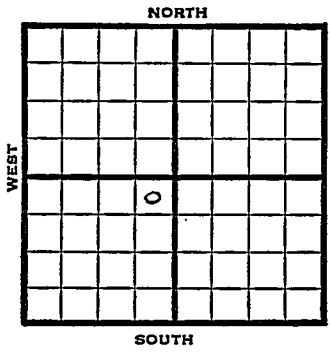

1950	REPORT
	Elev 1406
5/31	Spud 5-28-50
	8" @ 200'
	WOC
7/19	8" @ 200
	Lans 2881 Miss 3692
	Dol 3732
	5" @ 3735
	TD 3742
	1000 acid
	F/400 bopd
	Completed
	COMPLETED

Form 26 200 Bks. 11-49 Petrol Kansas

Barthlemew

Map No. ____ Sec. 31 Twp. 27 R. 4W

Well No. 5 Davis

Westgate Greenland Company

Jackson Contractor

NE NE SW

330 Ft. from N. Line

____ Ft. from S. Line

330 Ft. from E. Line

____ Ft. from W. Line

SECTION PLAT



Sedgwick

Location

Rig up

Drilling and Remarks:

Spud 5-28-50

8" C 200

W. O. C.

RECORD

Cased ____ in., ____ ft.

Sand

Gas

Oil

Total Depth

PRODUCTION

1st 24 hrs. Nat.

1st 24 hrs. after shot

Gas ____ Cu. Ft.

Dry Hole

Abandoned

Date

MAY 31 1950 19

J. E. TYRA Scout

Form 26 200 Bks. 11-49 Petrol

Kansas

Bartholomew

Map No. _____ Sec. 31 Twp. 27 R. 4W

Well No. 5 Davis


Westgate-Greenland Company

Contractor

NE NE SW

El. 1406

SECTION PLAT

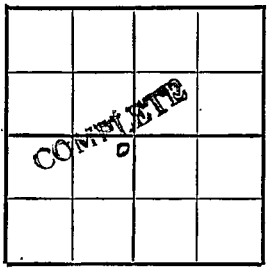

330 Ft. from N. Line

Ft. from S. Line

330 Ft. from E. Line

Ft. from W. Line

Sedgwick County

Location

Rig up

Drilling and Remarks:

8" @ 200

Lans. 2881

Miss. 3692

Dol. 3732

5" @ 3735

TD 3742

1000 acid

RECORD

Cased in., ft.

Sand

Gas

Oil

Total Depth 3742

PRODUCTION

1st 24 hrs. Nat.

1st 24 hrs. after shot

Gas Cu. Ft.

Dry Hole

Abandoned

F/ 400 bopd

Date Comp. JUL 19 1950

19 J. E. TYRA Scout