

Sedgwick

KANSAS

Sec. 31 Twp. 27 R. 4W

Well No. #8 Davis Farm

Westgate-Greenland Company

Jackson Drlg. Contractor

Bartholomew Pool

_____ Ft. from N. Line

330'


_____ Ft. from S. Line

_____ Ft. from E. Line

990'

_____ Ft. from W. Line

SE SW SW

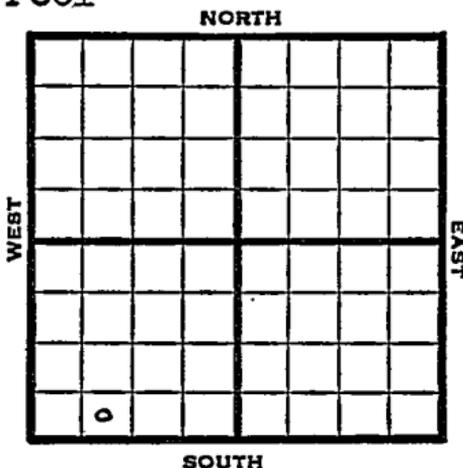

1950

Elev 1421' REPORT

9/27

Location

11/22

Spud 9-29-50
8 5/8" @ 198
Br Lime 2860
Land 2900
Miss 3717
Dol 3756
TD 3767
5" @ 3756
1000 A
S/35 BOPH
Comp 58 BOPD 50% water
Completed

COMPLETED

